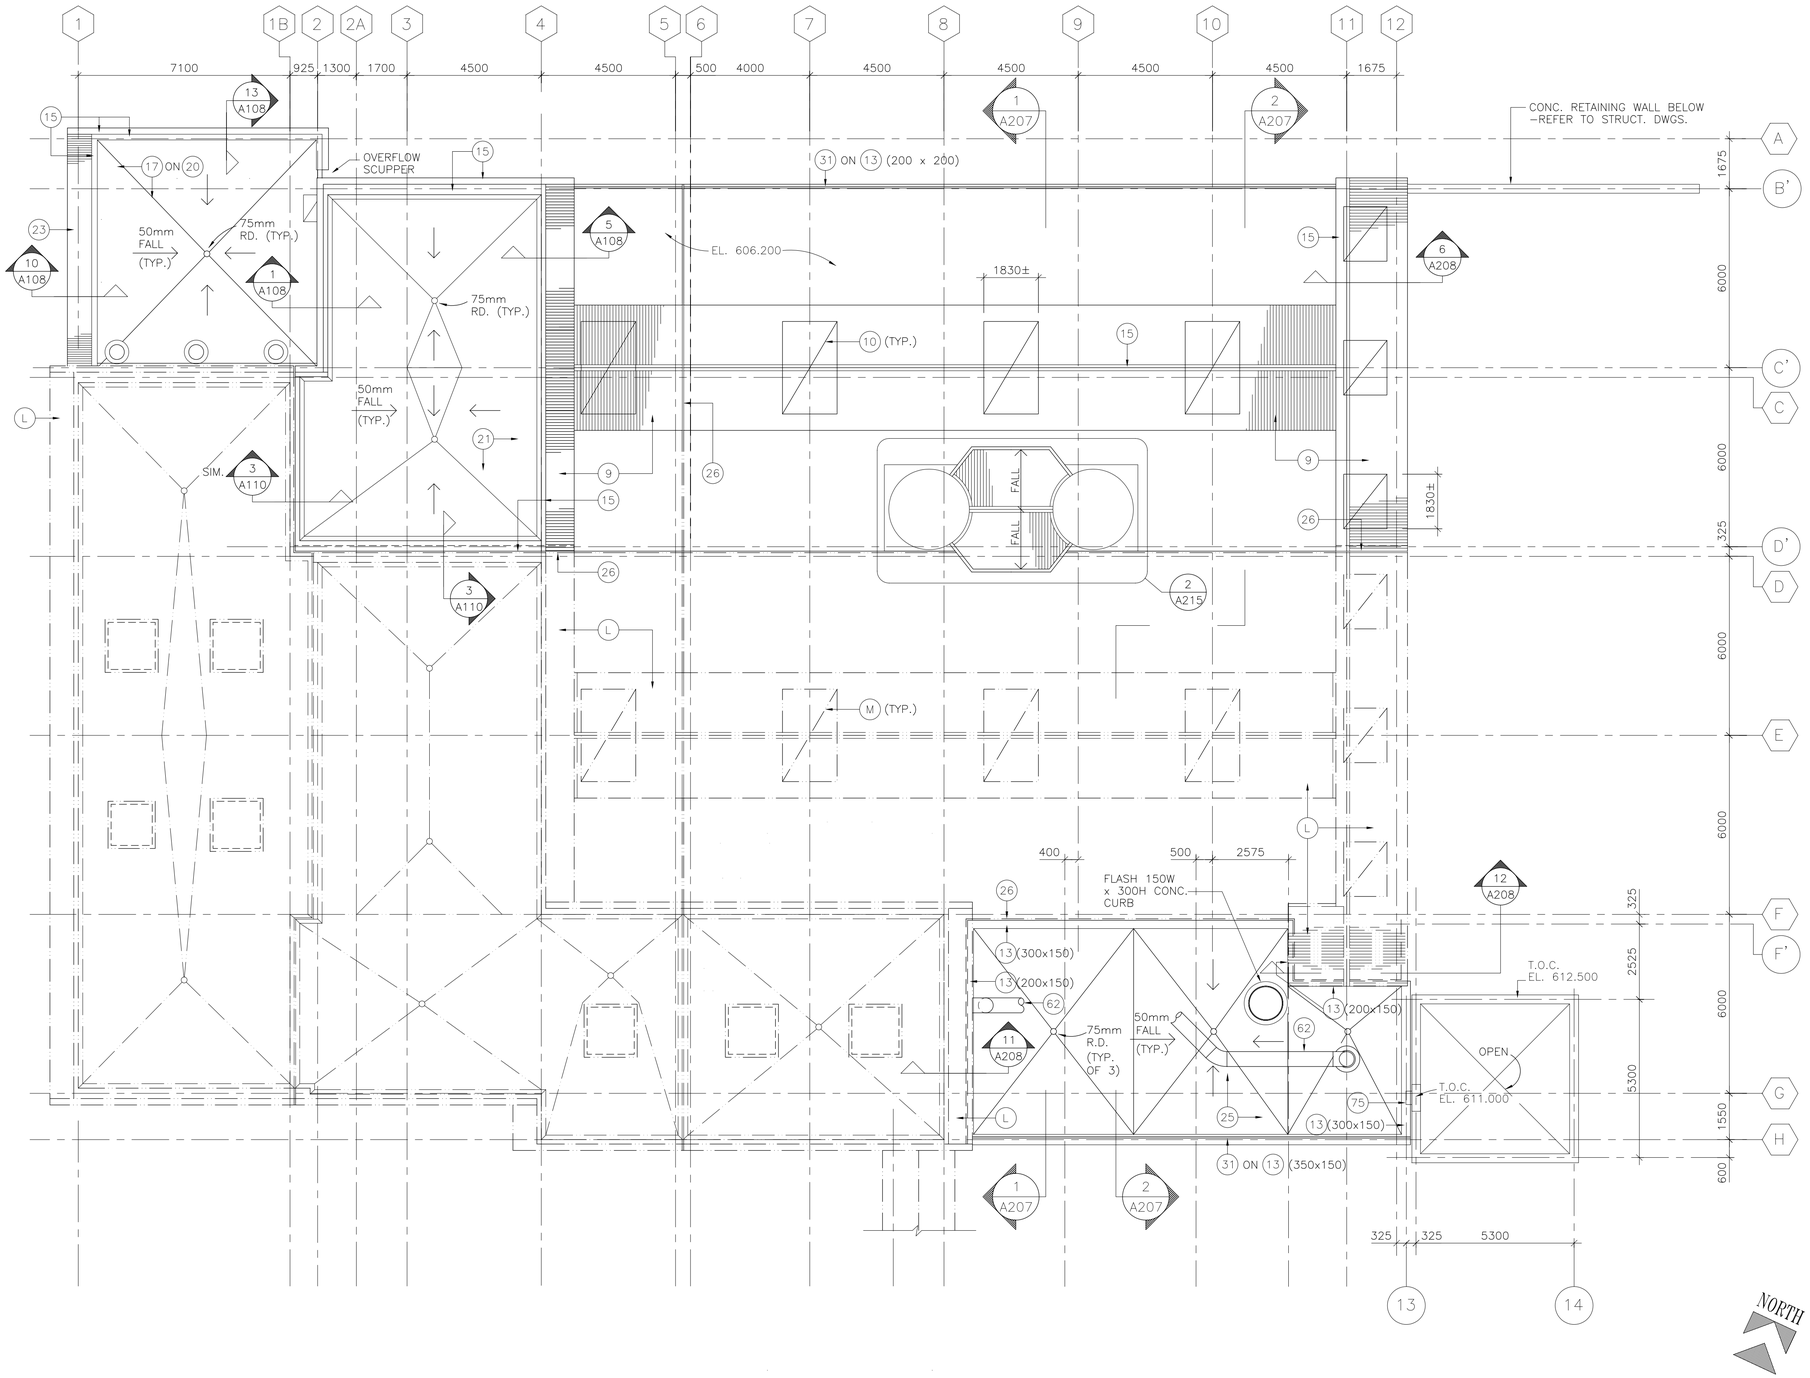

NOTE REFERENCES

EXISTING CONSTRUCTION

- (L) INSULATED PREFINISHED CORRUGATED STEEL CLADDING SYSTEM
- (M) CORRUGATED TRANSLUCENT SKYLIGHT PANEL

NEW CONSTRUCTION

- (9) INSULATED PREFINISHED CORRUGATED STEEL CLADDING SYSTEM (TO MATCH EXISTING)
- (10) CORRUGATED TRANSLUCENT SKYLIGHT PANEL (TO MATCH EXIST.)
- (13) CONC. CURB (W x H)
- (15) PREFINISHED STEEL FLASHING (BY CLADDING SUPPLIER)
- (17) 64mm CONC. WEARING SLAB ON 6MIL. POLYURETHANE SLIP SHEET ON 75mm RIGID INSULATION
- (20) 2 PLY SBS ROOFING
- (21) 2 PLY SBS ROOFING ON 100mm RIGID INSULATION ON VAPOUR RETARDANT
- (23) PREFINISHED CORRUGATED STEEL CLADDING ON STRUCTURAL STEEL SUPPORT FRAMING
- (25) CONCRETE SURFACE SEALER (REFER TO STRUCT. SPEC.)
- (26) CONTINUOUS SEALANT & BACK–UP ROD.
- (31) GALV. STEEL GUARDRAIL (REFER MECH. DWGS.)
- (62) SHEET METAL DUCT (REFER MECH. DWGS.)
- (75) GALV. STEEL ACCESS LADDER (REFER MECH. DWGS.)

TOBY RUSSELL BUCKWELL
& partners architects
1650 ALBERNI STREET, VANCOUVER, B.C.
CANADA, V6G 1B1. TEL.: [604] 682–6881
FAX: [604] 682–3081

ACAD DWG. A104 1:100 96–04–24

AutoCAD DRAWING

REVISIONS	ISSUE	DATE	DRAWN	CHK'D	APP'D	DESCRIPTION	ISSUE	DATE	DRAWN	CHK'D	APP'D	DESCRIPTION
	B	APR/96	E.S.	C.O.	C.O.	ISSUED FOR CONSTRUCTION						
						INCLUDES ADDENDA ITEMS						

DESIGNED D.K.M.
DRAWN B.D.C.
CHECKED C.O.

DAYTON & KNIGHT LTD.
Consulting Engineers

RESORT MUNICIPALITY OF WHISTLER
WASTEWATER TREATMENT PLANT–STAGE III EXPANSION – CONTRACT 1
HEADWORKS & PRIMARY SED. TANKS
ROOF PLAN

SCALE: 1:100
A104/A204
DRAWING No. 179.11.1
SHEET 45 OF 249 ISSUE B