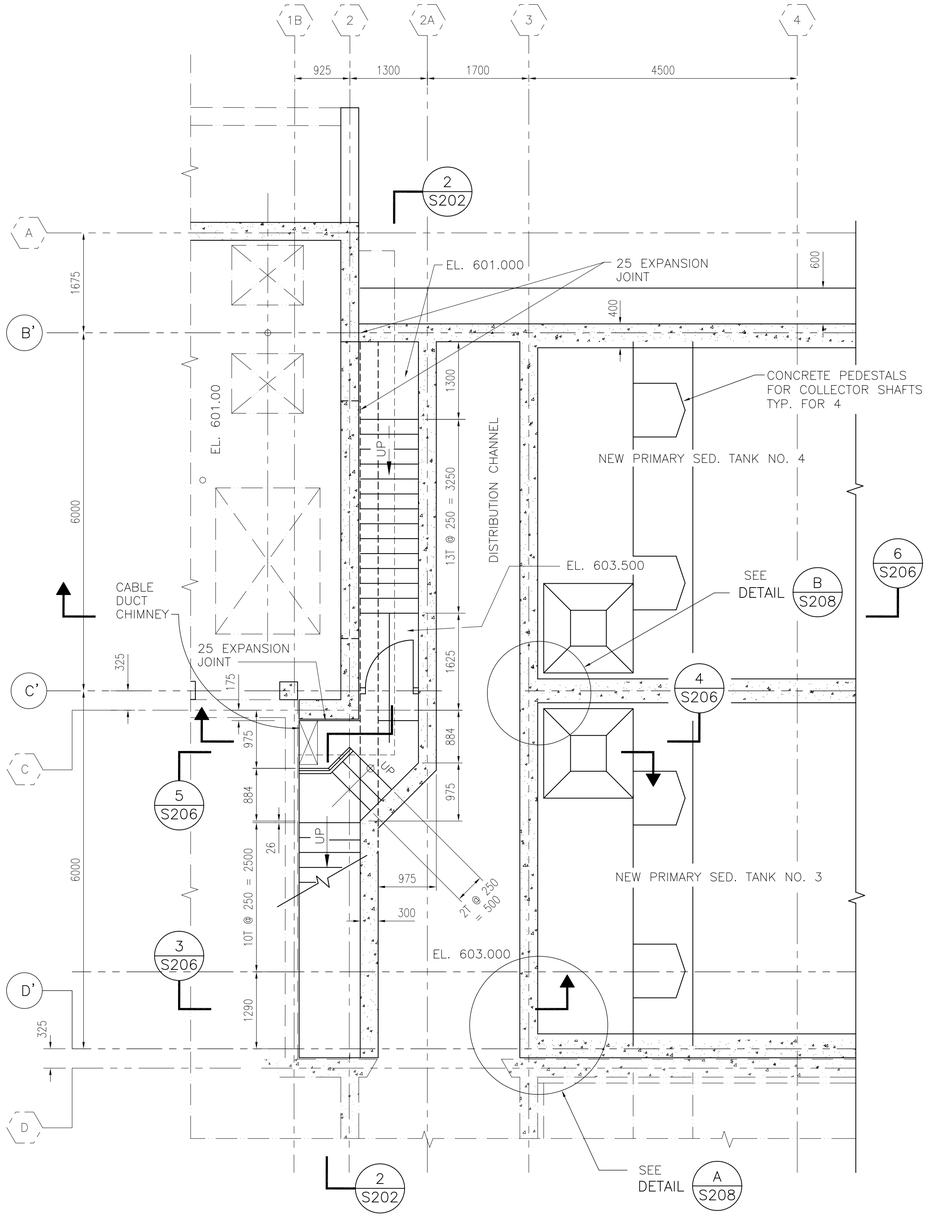

PLAN @ EL. 603.000
1:50

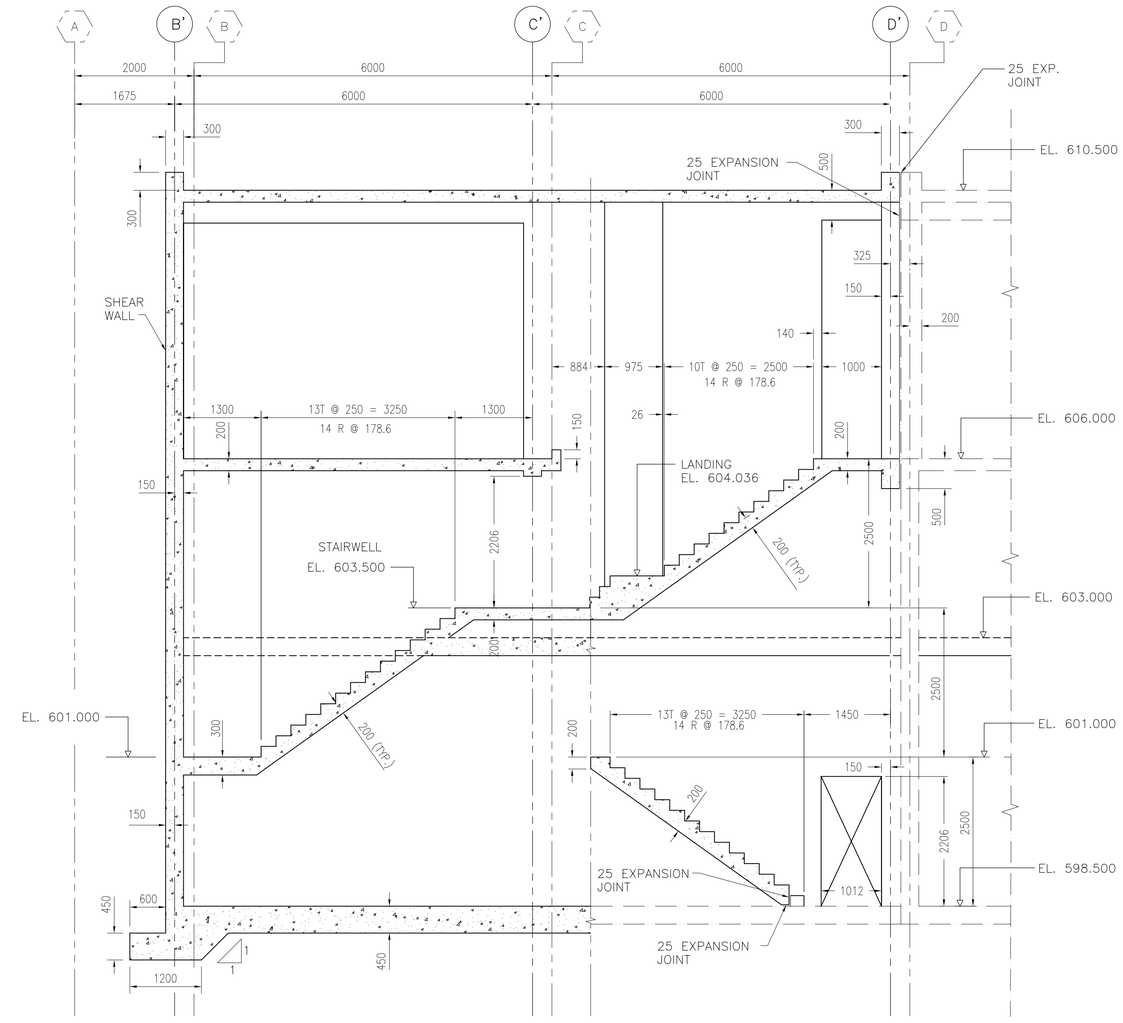

SECTION 2 S202 2 S201 2 S101
1:50

ACAD DWG. S202 1:50 98-01-23

REVISIONS	ISSUE	DATE	DRAWN	CHK'D	APP'D	DESCRIPTION	ISSUE	DATE	DRAWN	CHK'D	APP'D	DESCRIPTION
	B	APR/96	DBC	H.K.	H.K.	ISSUED FOR CONSTRUCTION						
	C	JAN/98	JC			RECORD DRAWING						

AutoCAD DRAWING

DESIGNED H.K.
DRAWN WSL/AEW/KM
CHECKED H.K.

DAYTON & KNIGHT LTD.
Consulting Engineers

RESORT MUNICIPALITY OF WHISTLER
WASTE WATER TREATMENT PLANT–STAGE III EXPANSION–CONTRACT 1
PRIMARY SED. TANKS–PLAN @ EL. 603.000 – SECTIONS

SCALE: 1:50
S202
DRAWING No. 179.11.1
SHEET 76 OF 249 ISSUE C