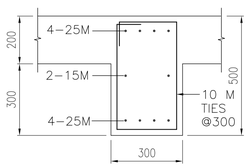

SECTION 1/S210
1:12.5

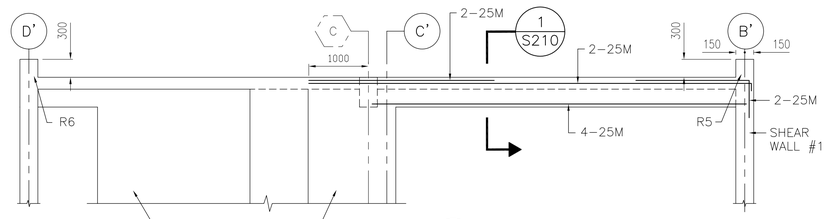

ROOF BEAM R1/S210
1:50

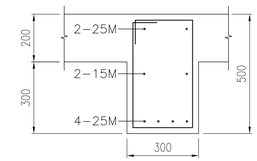

SECTION 2/S210
1:12.5

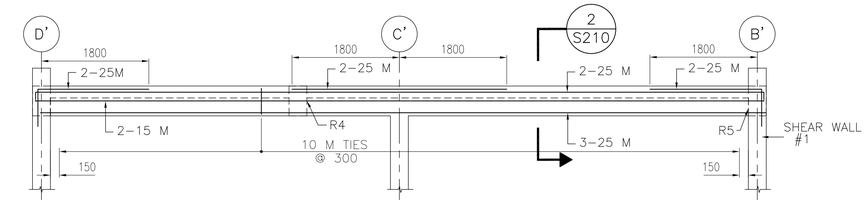

ROOF BEAM R2/S210
1:50

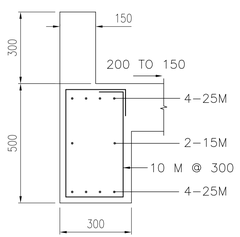

SECTION 3/S210
1:12.5

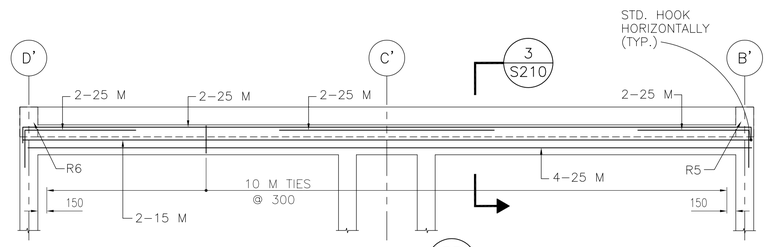

ROOF BEAM R3/S210
1:50

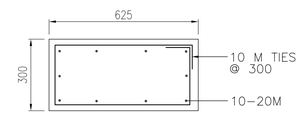

ROOF COLUMN DETAIL AT BAY LINE D' & 2
1:12.5

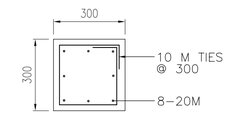

DETAIL C/S210
1:12.5

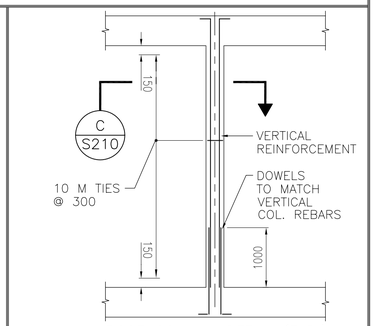

ROOF COLUMN DETAIL (TYP.)
ELEVATION
1:50

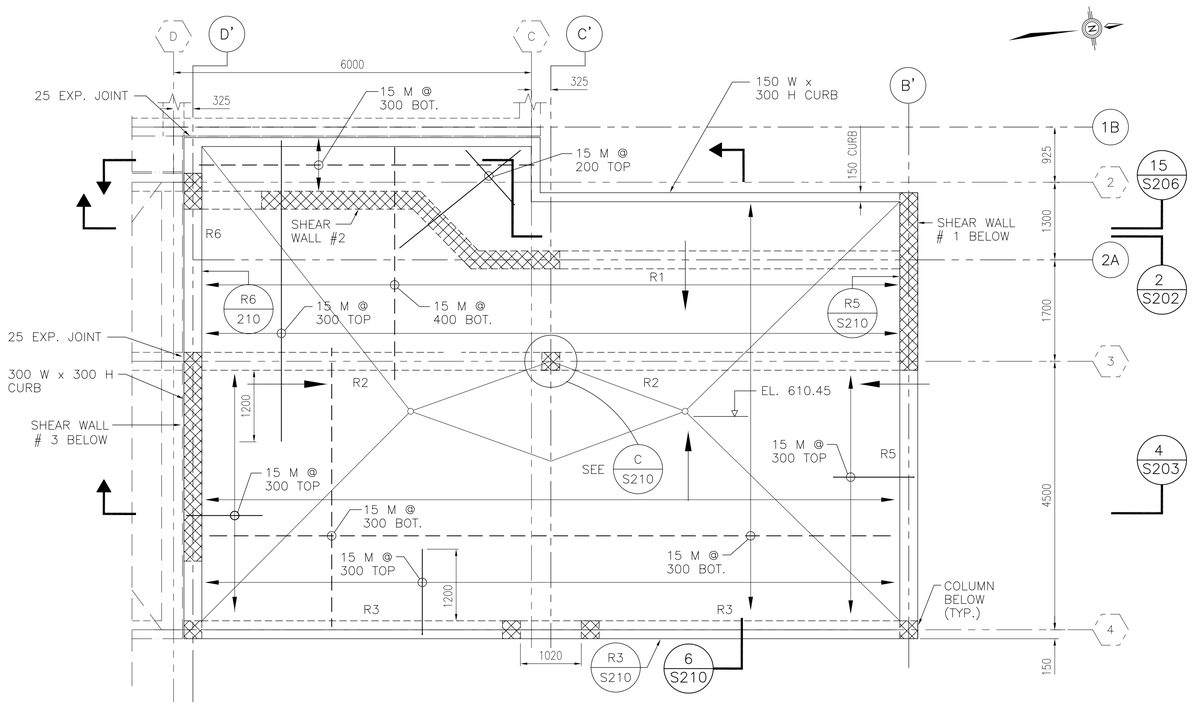

ROOF PLAN @ ELEV. 610.500
1:50

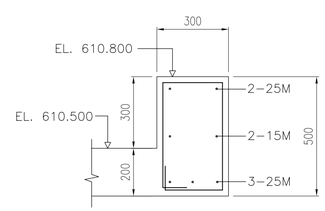

SECTION 5/S210
1:12.5

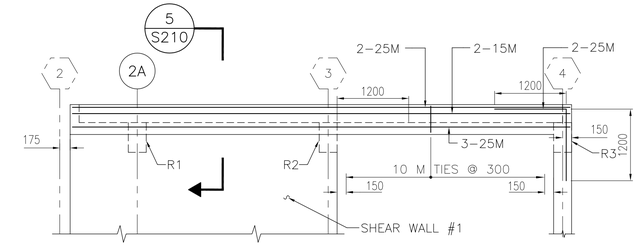

ROOF BEAM R5/S210
1:50

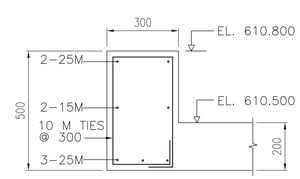

SECTION 6/S210
1:12.5

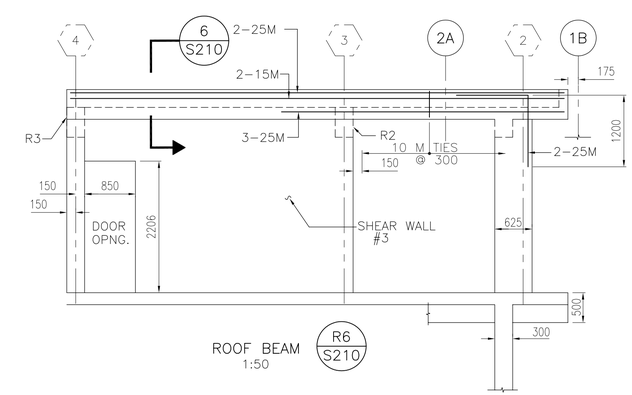

ROOF BEAM R6/S210
1:50

ACAD DWG S210 1:50 98-01-27

AutoCAD DRAWING

REVISIONS

ISSUE	DATE	DRAWN	CHK'D	APP'D	DESCRIPTION	ISSUE	DATE	DRAWN	CHK'D	APP'D	DESCRIPTION
B	APR/96	DBC	S.O.	S.O.	ISSUED FOR CONSTRUCTION						
C	JAN/98	JC			RECORD DRAWING						

DESIGNED R.W./S.O.
DRAWN WLP/ES
CHECKED H.K.

DAYTON & KNIGHT LTD.
Consulting Engineers

RESORT MUNICIPALITY OF WHISTLER
WASTEWATER TREATMENT PLANT–STAGE III EXPANSION–CONTRACT 1
PRIMARY SEDIMENTATION TANKS – ROOF PLAN @ EL. 610.500

SCALE: 1:50 S210
DRAWING No. 179.11.1
SHEET 84 OF 249 ISSUE C