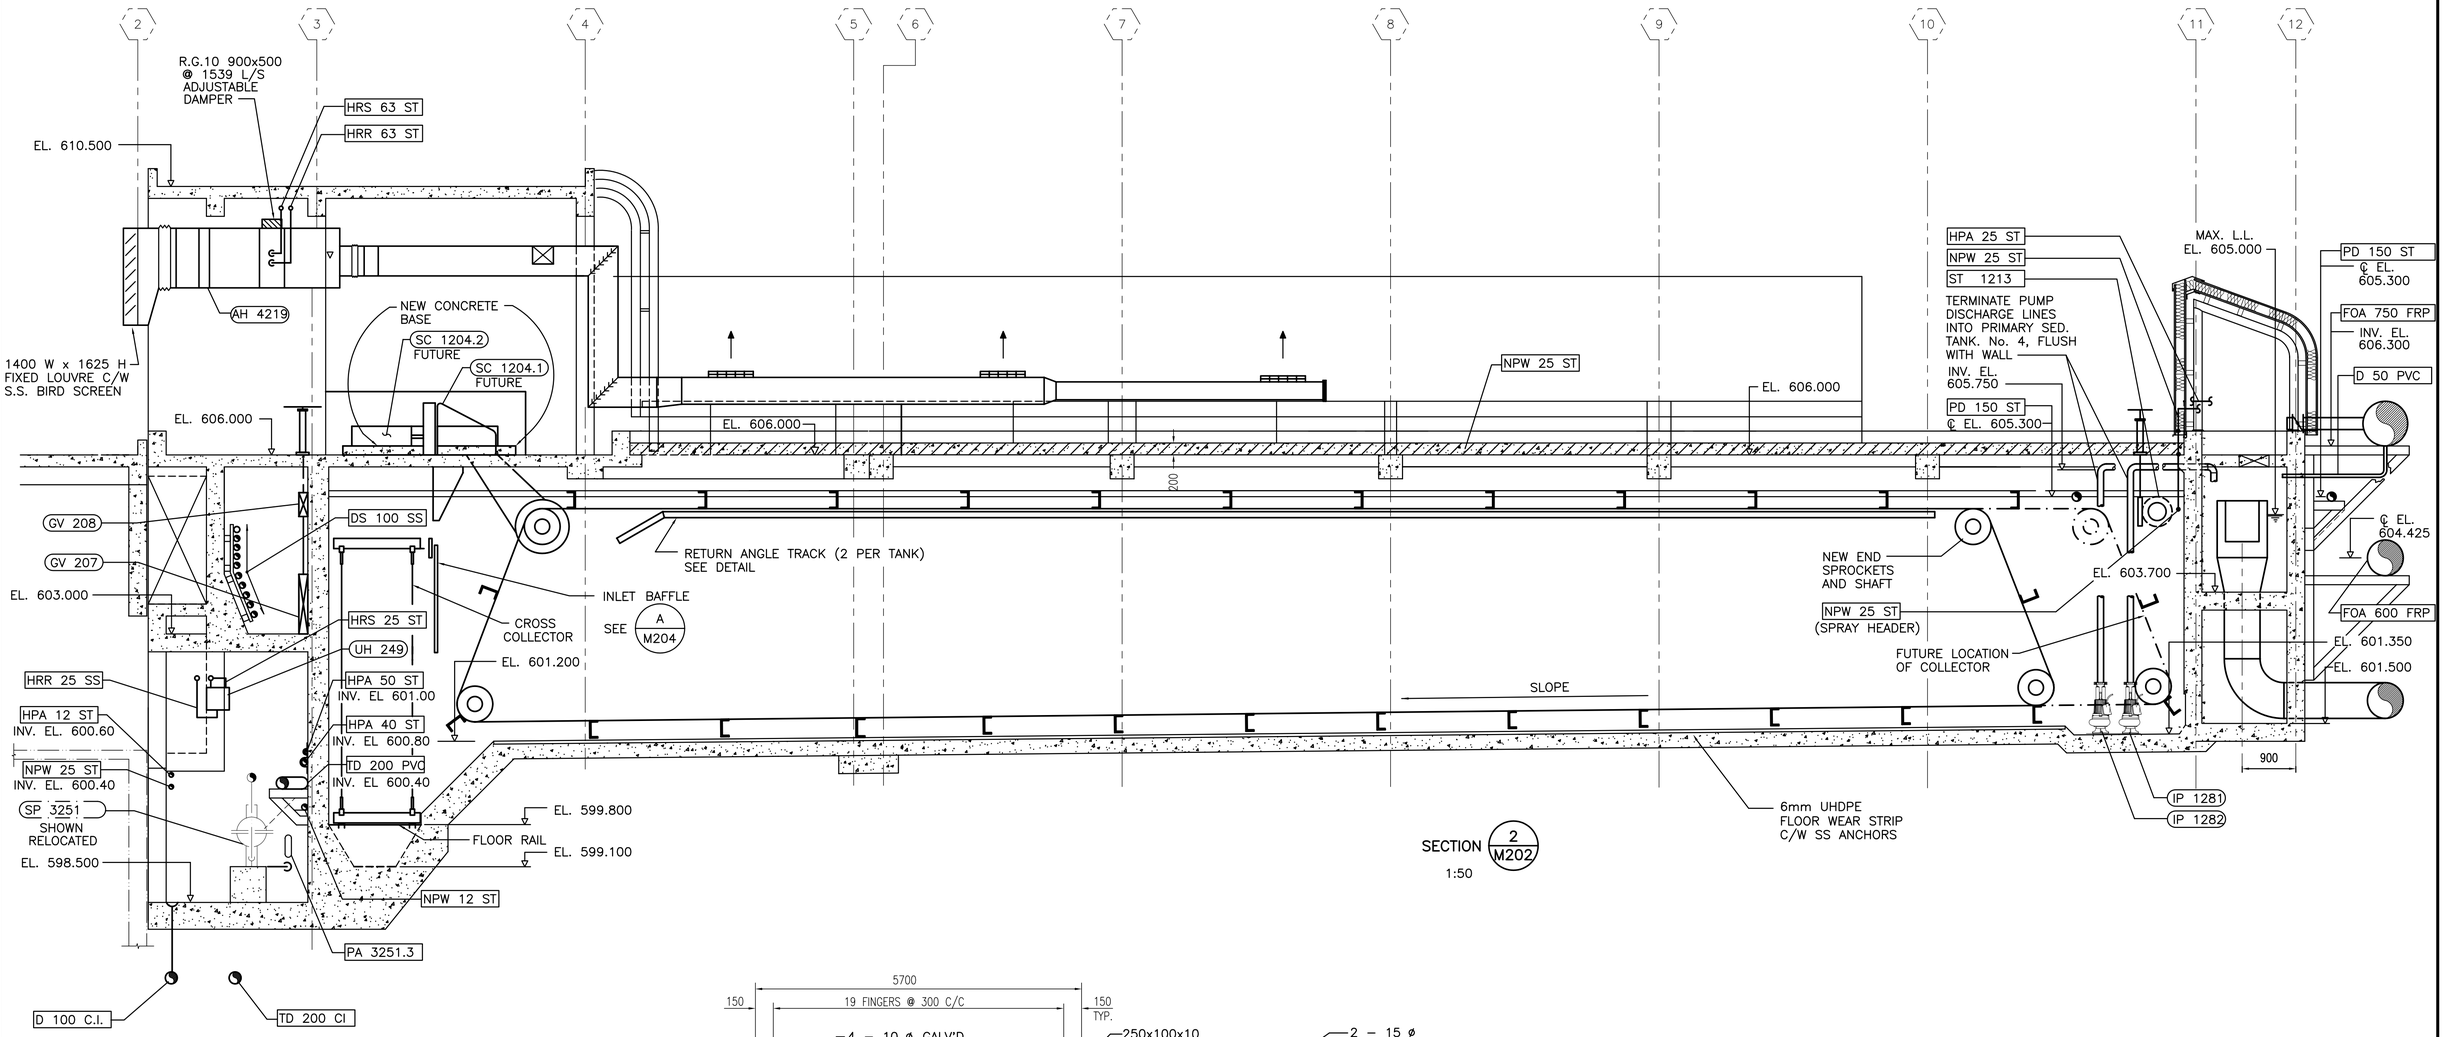

SECTION 2 M202
1:50

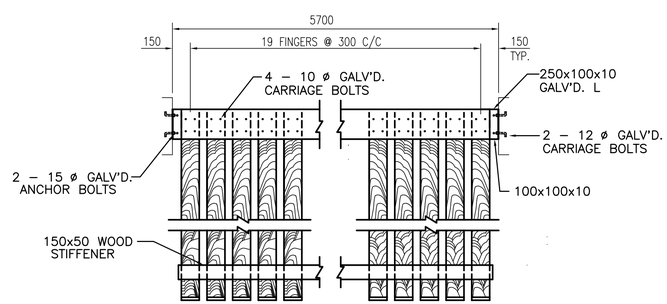

FINGER BAFFLE
DETAIL A M204
N.T.S.

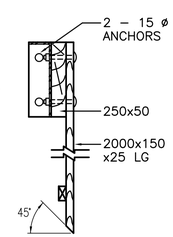

SECTION
1:10

NOTES :
1. EF 1223 NOT SHOWN FOR CLARITY.

NOTES:
1) MECHANICAL WORKS SIMILAR FOR FOR PRIMARY SED. TANK No. #3
2) PROVIDE ALL END SPROCKET INSERTS FOR THE FUTURE COLLECTOR LOCATION FOR PRIMARY SED. TANK No. #4.

ACAD DWG. M204 1:50 98-02-18

AutoCAD DRAWING

REVISIONS

ISSUE	DATE	DRAWN	CHK'D	APP'D	DESCRIPTION	ISSUE	DATE	DRAWN	CHK'D	APP'D	DESCRIPTION
B	APR/96	LW	HK	HK	ISSUED FOR CONSTRUCTION						
C	FEB/98	JC			RECORD DRAWING						

DESIGNED H.P.W.
DRAWN WSL/KM/ES
CHECKED HK

DAYTON & KNIGHT LTD.
Consulting Engineers

RESORT MUNICIPALITY OF WHISTLER
WASTEWATER TREATMENT PLANT–STAGE III EXPANSION–CONTRACT 1
PRIMARY SEDIMENTATION TANK – SECTION

SCALE: AS SHOWN
M204
DRAWING No. 179.11.1
SHEET 128 OF 249 ISSUE C