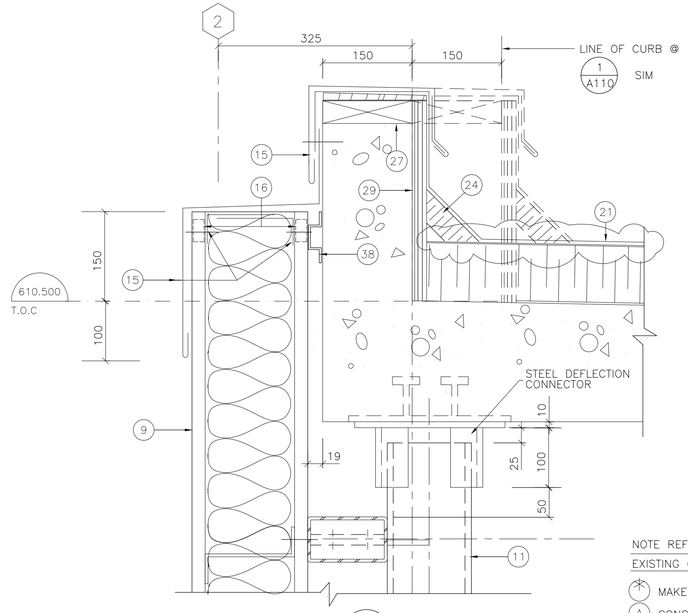

1 A108 WALL/CURB DETAIL 1:5

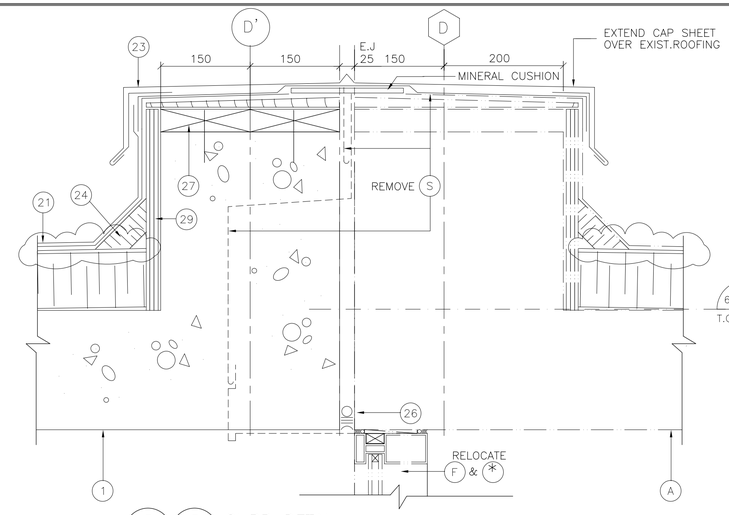

3 A108 3 A104 CURB DETAIL 1:5

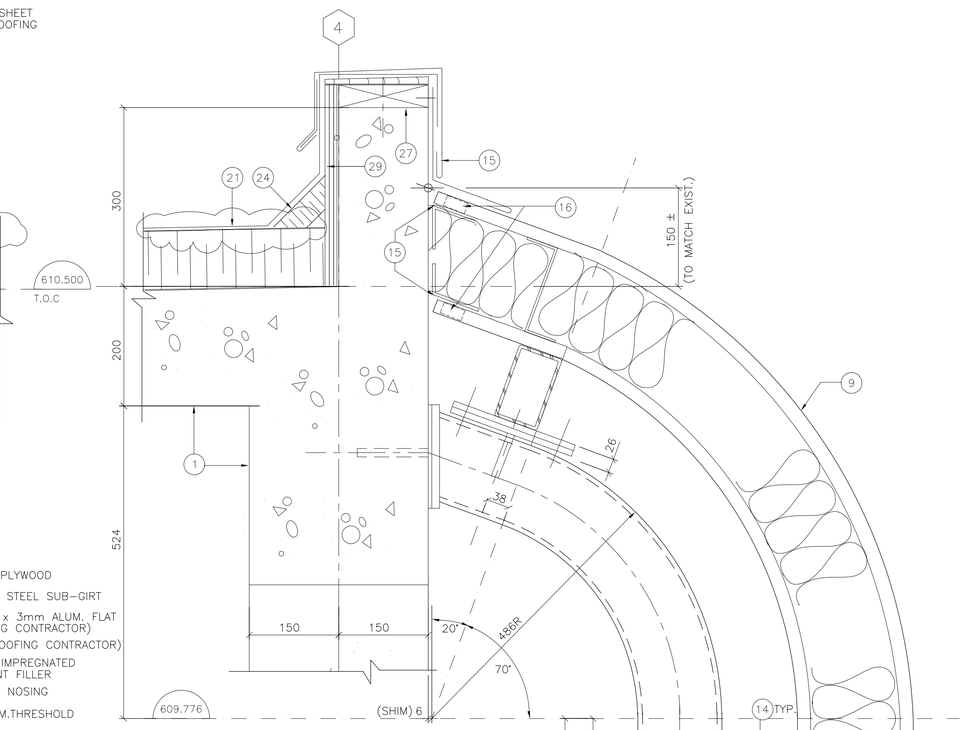

6 A108 WALL/CURB 1:5

NOTE REFERENCES:

EXISTING CONSTRUCTION

- * MAKE GOOD ALL EXPOSED/DISTURBED SURFACES
- A CONCRETE
- F DOUBLE GLAZING IN ALUM.FRAMES
- L INSULATED PREFINISHED CORRUGATED STEEL CLADDING SYSTEM
- S PREFINISHED STEEL FLASHING

NEW CONSTRUCTION

- 1 CONCRETE
- 9 INSULATED PREFINISHED CORRUGATED STEEL CLADDING SYSTEM(TO MATCH EXISTING)
- 11 141 ∅ H.S.S. COLUMN
- 14 127 x 76.2 H.S.S GIRT/OR DOOR POST
- 15 PREFINISHED STEEL FLASHING (BY CLADDING SUPPLIER)
- 16 CONTINUOUS NEOPRENE CELL CLOSER (BY CLADDING SUPPLIER)
- 17 64mm CONC. WEARING SLAB ON 6MIL. POLYURETHANE SLIP SHEET ON 75mm INSULATION
- 18 CAULKING & BACK-UP ROD (BY CLADDING SUPPLIER)
- 19 CAULKING & BACK-UP ROD (BY GENERAL CONTRACTOR)
- 20 2 PLY SBS ROOFING
- 21 2 PLY S.B.S ROOFING ON 100mm RIGID INSULATION ON VAPOUR RETARDANT
- 24 FIBRE CANT STRIP
- 23 FIELD PAINTED 0.76MM ALUM.FLASHING C/W 75 x 1.22mm ALUM.HOLD DOWN CLIPS AT 1200mm O.C (BY ROOFING CONTRACTOR)
- 26 CONTINUOUS SEALANT & BACK-UP ROD
- 27 TREATED CONT.38mm WOOD PLATE C/W BEVELLED CEDAR SIDING CAP
- 29 TREATED 19mm PLYWOOD
- 38 19mm x 1.6mm STEEL SUB-GIRT
- 39 CONTINUOUS 25 x 3mm ALUM. FLAT BAR (BY ROOFING CONTRACTOR)
- 40 CAULKING (BY ROOFING CONTRACTOR)
- 54 19mm BITUMEN IMPREGNATED FIBREBOARD JOINT FILLER
- 57 PEMKO 326 SILL NOSING
- 58 PEMKO 114 ALUM.THRESHOLD
- 60 SEE A102

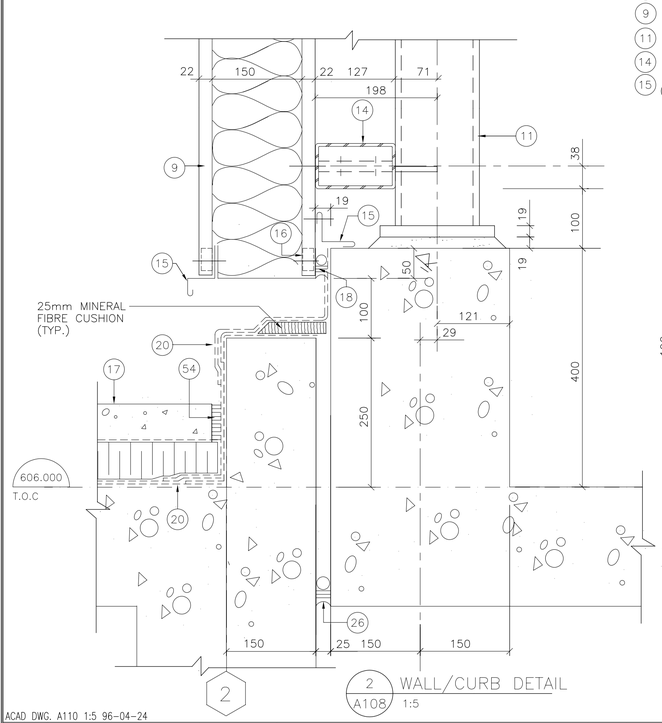

2 A108 WALL/CURB DETAIL 1:5

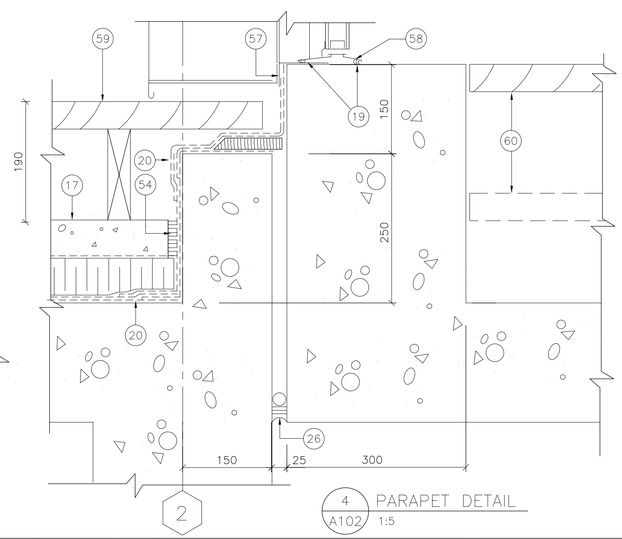

4 A102 PARAPET DETAIL 1:5

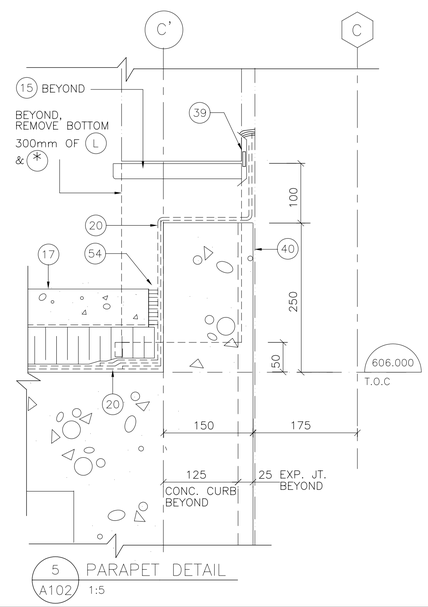

5 A102 PARAPET DETAIL 1:5

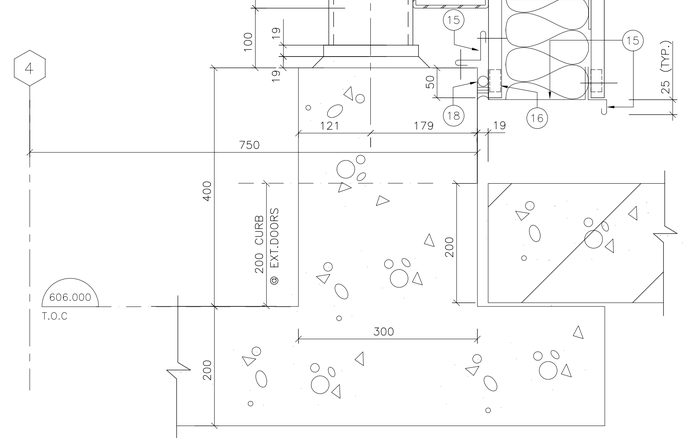

7 A108 WALL DETAIL 1:5

TOBY RUSSELL BUCKWELL & partners architects
1650 ALBERNI STREET, VANCOUVER, B.C.
CANADA, V6G 1B1. TEL.: [604] 682-6881
FAX: [604] 682-3081

ACAD DWG. A110 1:5 96-04-24

AutoCAD DRAWING

REVISIONS	ISSUE	DATE	DRAWN	CHK'D	APP'D	DESCRIPTION	ISSUE	DATE	DRAWN	CHK'D	APP'D	DESCRIPTION
	B	APR/96	E.S.	C.O.	C.O.	ISSUED FOR CONSTRUCTION						
						INCLUDES ADDENDA ITEMS						

DESIGNED D.K.M.
DRAWN B.D.C.
CHECKED C.O.

DAYTON & KNIGHT LTD.
Consulting Engineers

RESORT MUNICIPALITY OF WHISTLER
WASTEWATER TREATMENT PLANT-STAGE III EXPANSION - CONTRACT 1
HEADWORKS & PRIMARY SED. TANKS
DETAILS - SHEET 2

SCALE: 1:5
A110/A210
DRAWING No. 179.11.1
SHEET 51 OF 249 ISSUE B