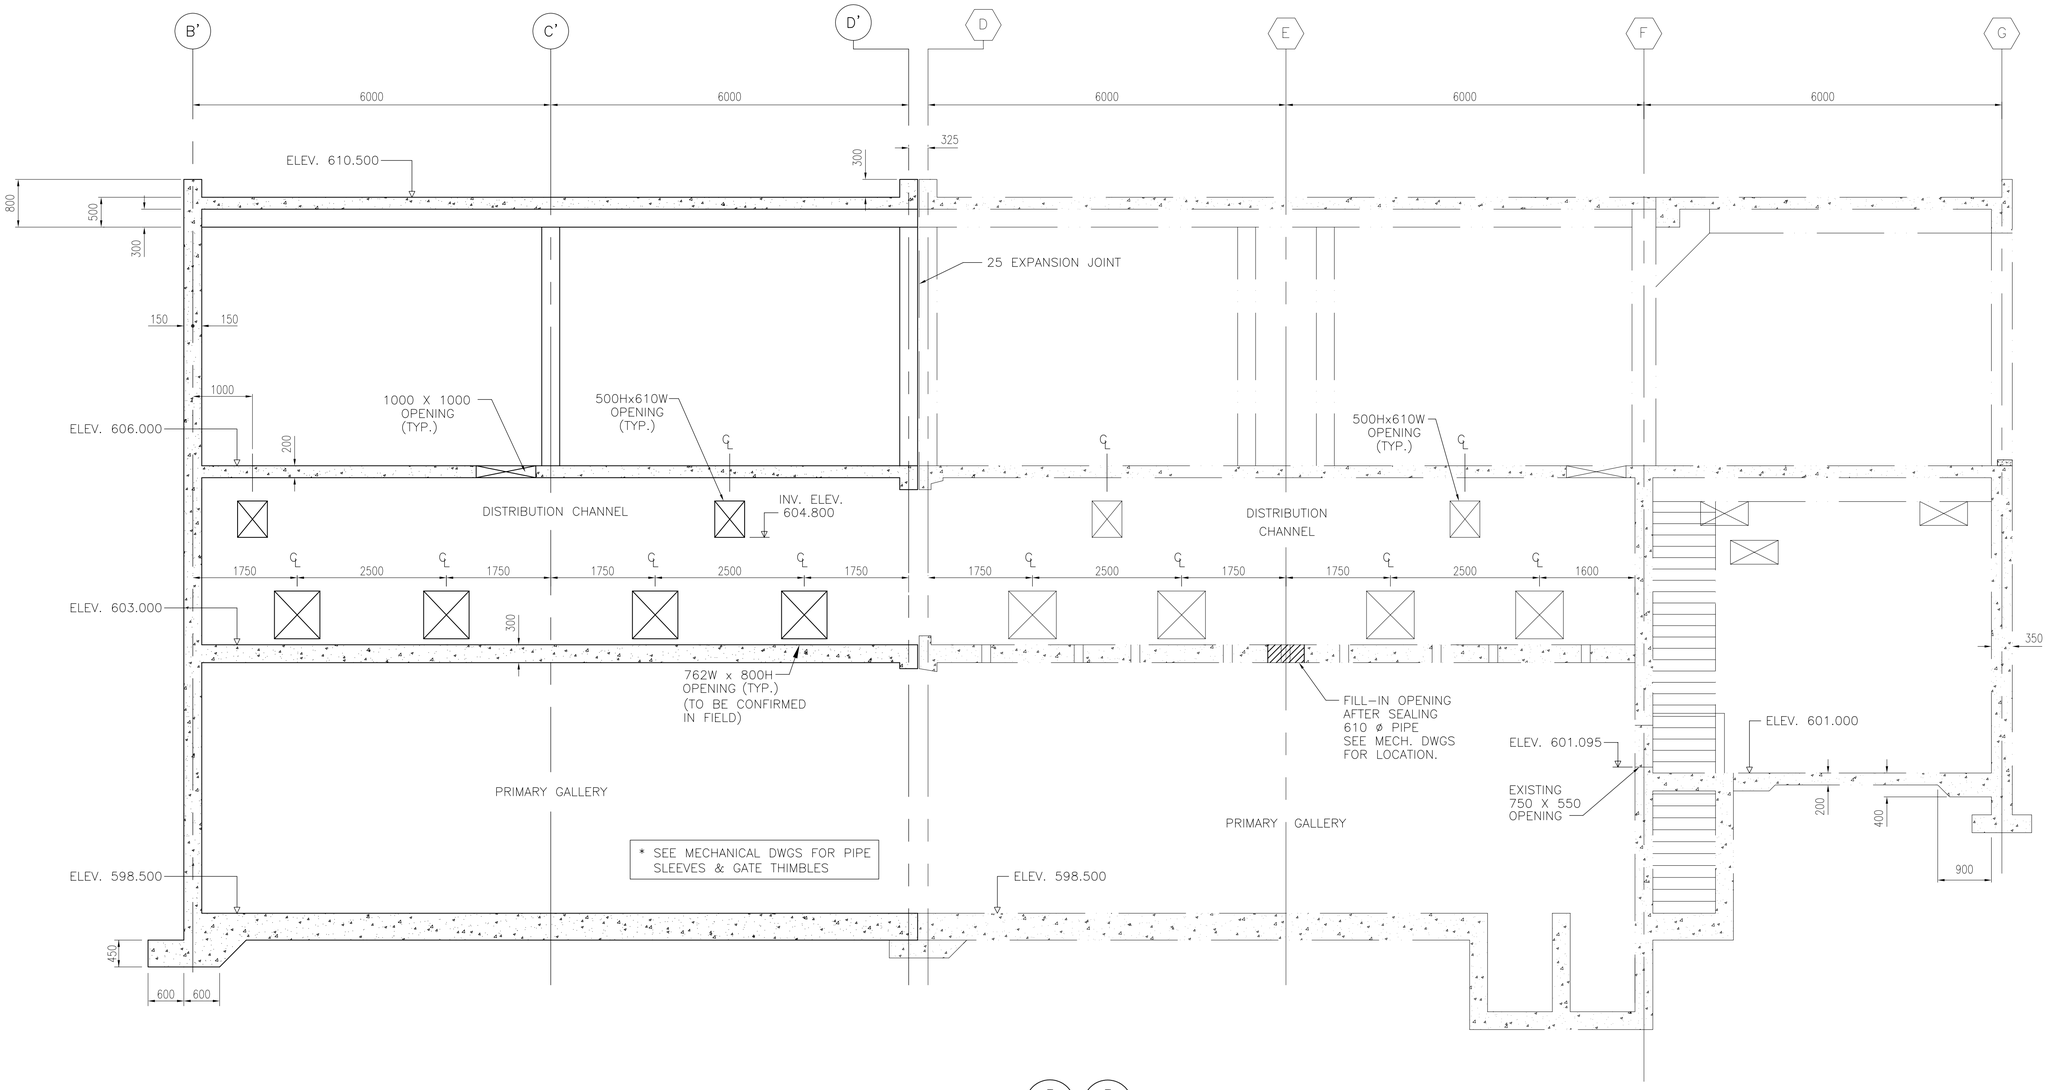

SECTION 3/S201 3/S203

ACAD DWG. S204 1:50 98-01-26

AutoCAD DRAWING

REVISIONS	ISSUE	DATE	DRAWN	CHK'D	APP'D	DESCRIPTION	ISSUE	DATE	DRAWN	CHK'D	APP'D	DESCRIPTION
	B	APR/96	DBC	R.W.	R.W.	ISSUED FOR CONSTRUCTION						
	C	JAN/98	JC			RECORD DRAWING						

DESIGNED R.W.
DRAWN WSL/G.S.
CHECKED H.K.

DAYTON & KNIGHT LTD.
Consulting Engineers

RESORT MUNICIPALITY OF WHISTLER
WASTEWATER TREATMENT PLANT–STAGE III EXPANSION–CONTRACT 1
PRIMARY SEDIMENTATION TANKS–SECTIONS

SCALE: 1:50
S204
DRAWING No. 179.11.1
SHEET 78 OF 249 ISSUE C