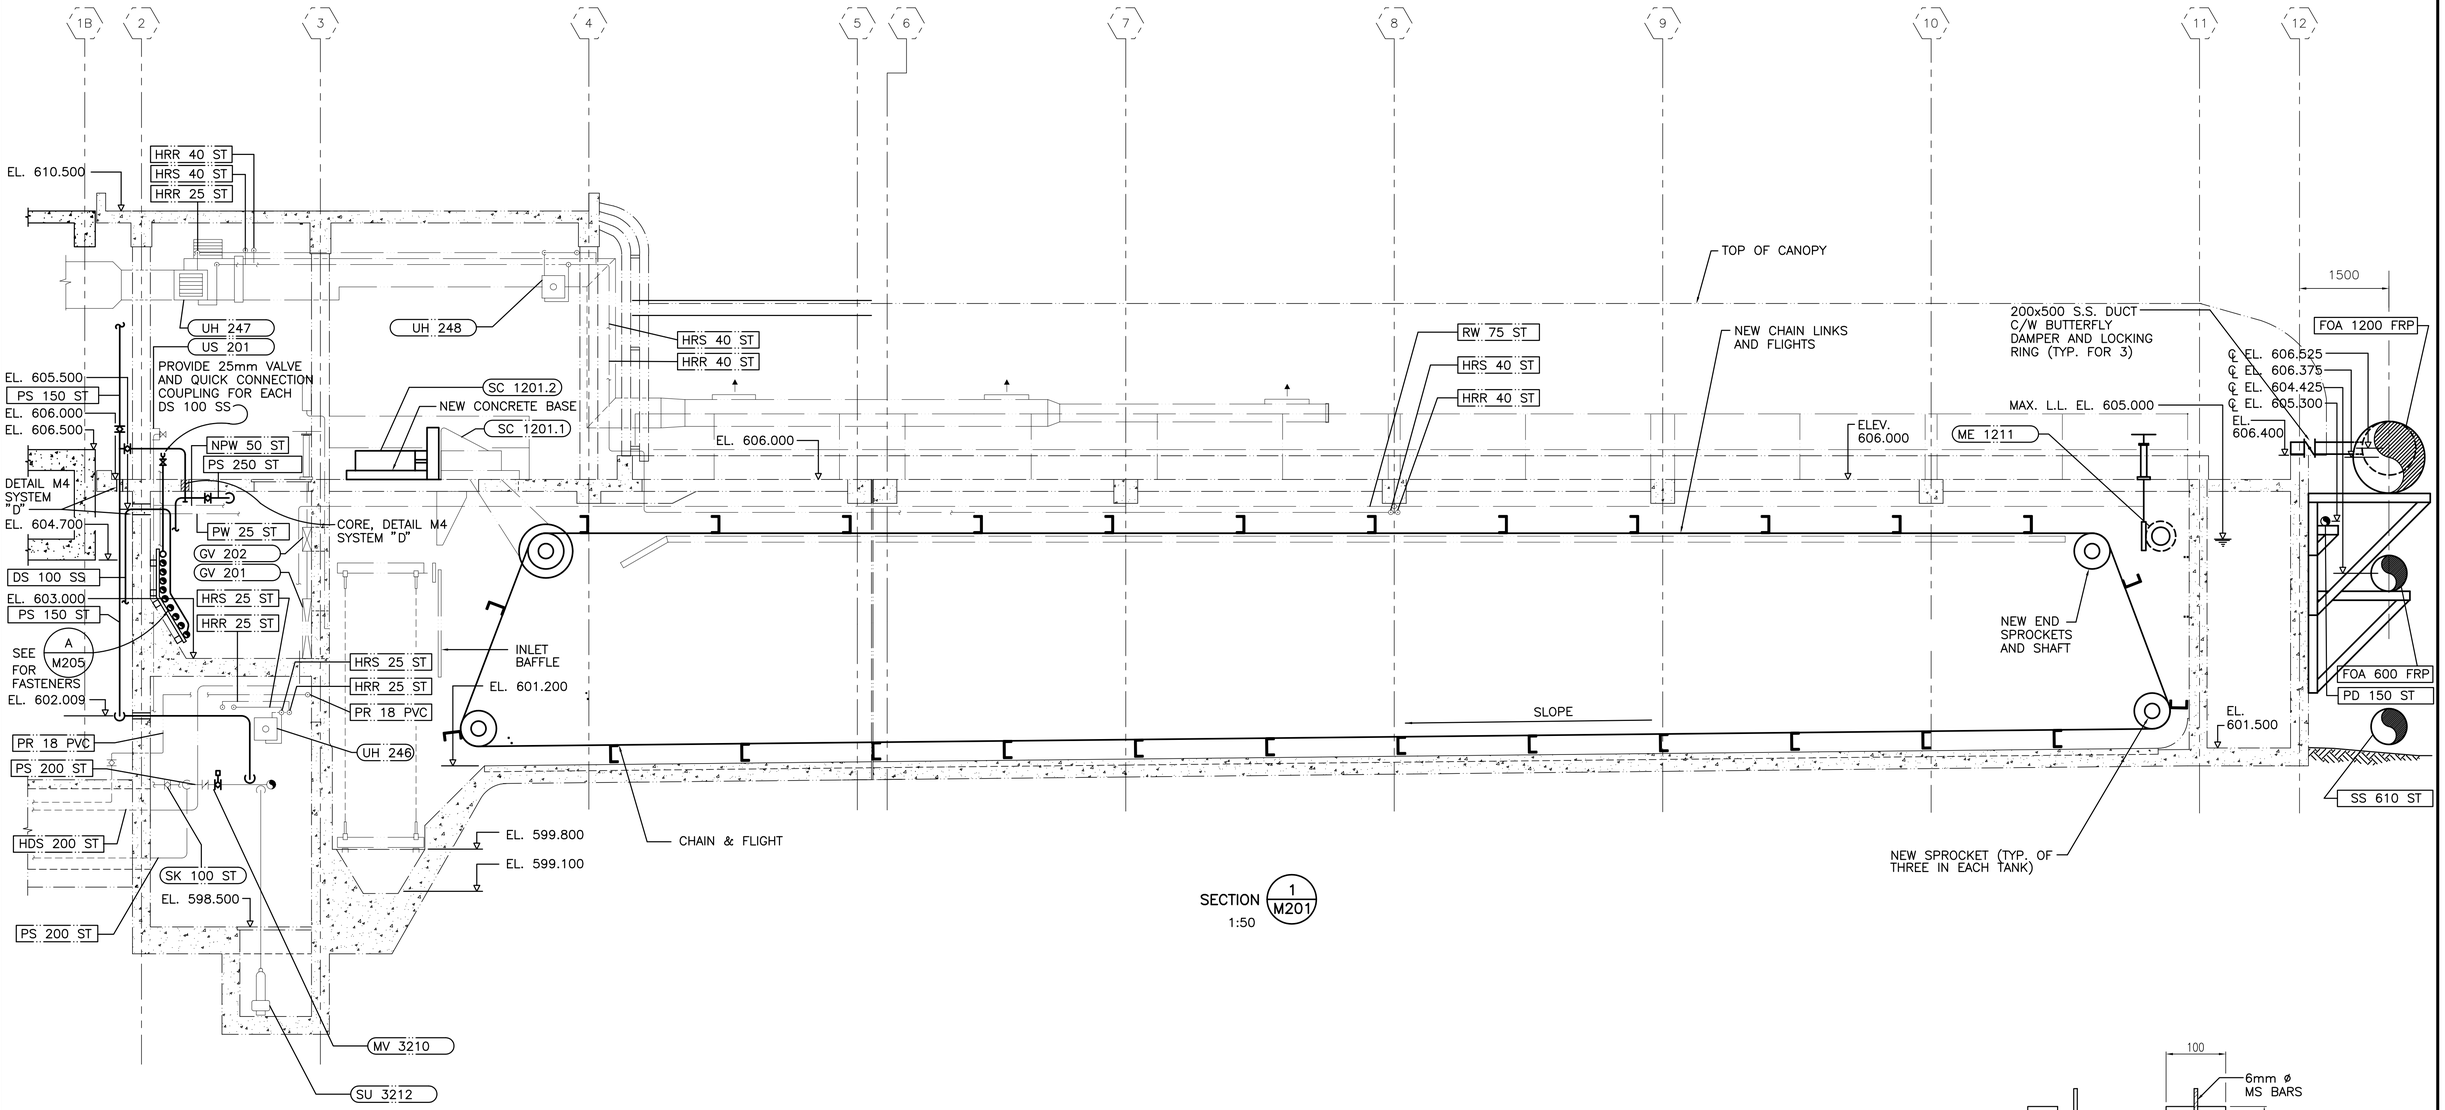

SECTION 1/M201
1:50

NOTE :
MECHANICAL RETROFIT WORKS
SIMILAR FOR PRIMARY SED. TANK No. #2

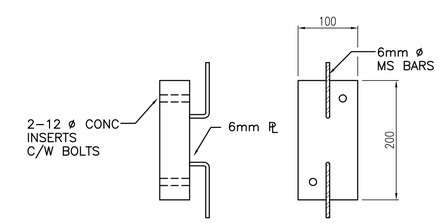

CHAIN HOOK DETAIL
(PROVIDE FOR ALL GALLERY VALVE CHAINS HOT DIP GALVANIZE ALL PARTS)

DETAIL C/M203
1:5

ACAD DWG. M203 1:50 98-02-18

AutoCAD DRAWING

REVISIONS	ISSUE	DATE	DRAWN	CHK'D	APP'D	DESCRIPTION	ISSUE	DATE	DRAWN	CHK'D	APP'D	DESCRIPTION
	B	APR/96	LW	HK	HK	ISSUED FOR CONSTRUCTION						
	C	FEB/98	JC			RECORD DRAWING						

DESIGNED H.P.W.
DRAWN WSL/KM/LW/ES
CHECKED HK

DAYTON & KNIGHT LTD.
Consulting Engineers

RESORT MUNICIPALITY OF WHISTLER
WASTEWATER TREATMENT PLANT–STAGE III EXPANSION–CONTRACT 1
EXISTING PRIMARY SEDIMENTATION TANK – SECTION

SCALE: 1:50
M203
DRAWING No. 179.11.1
SHEET 127 OF 249 ISSUE C