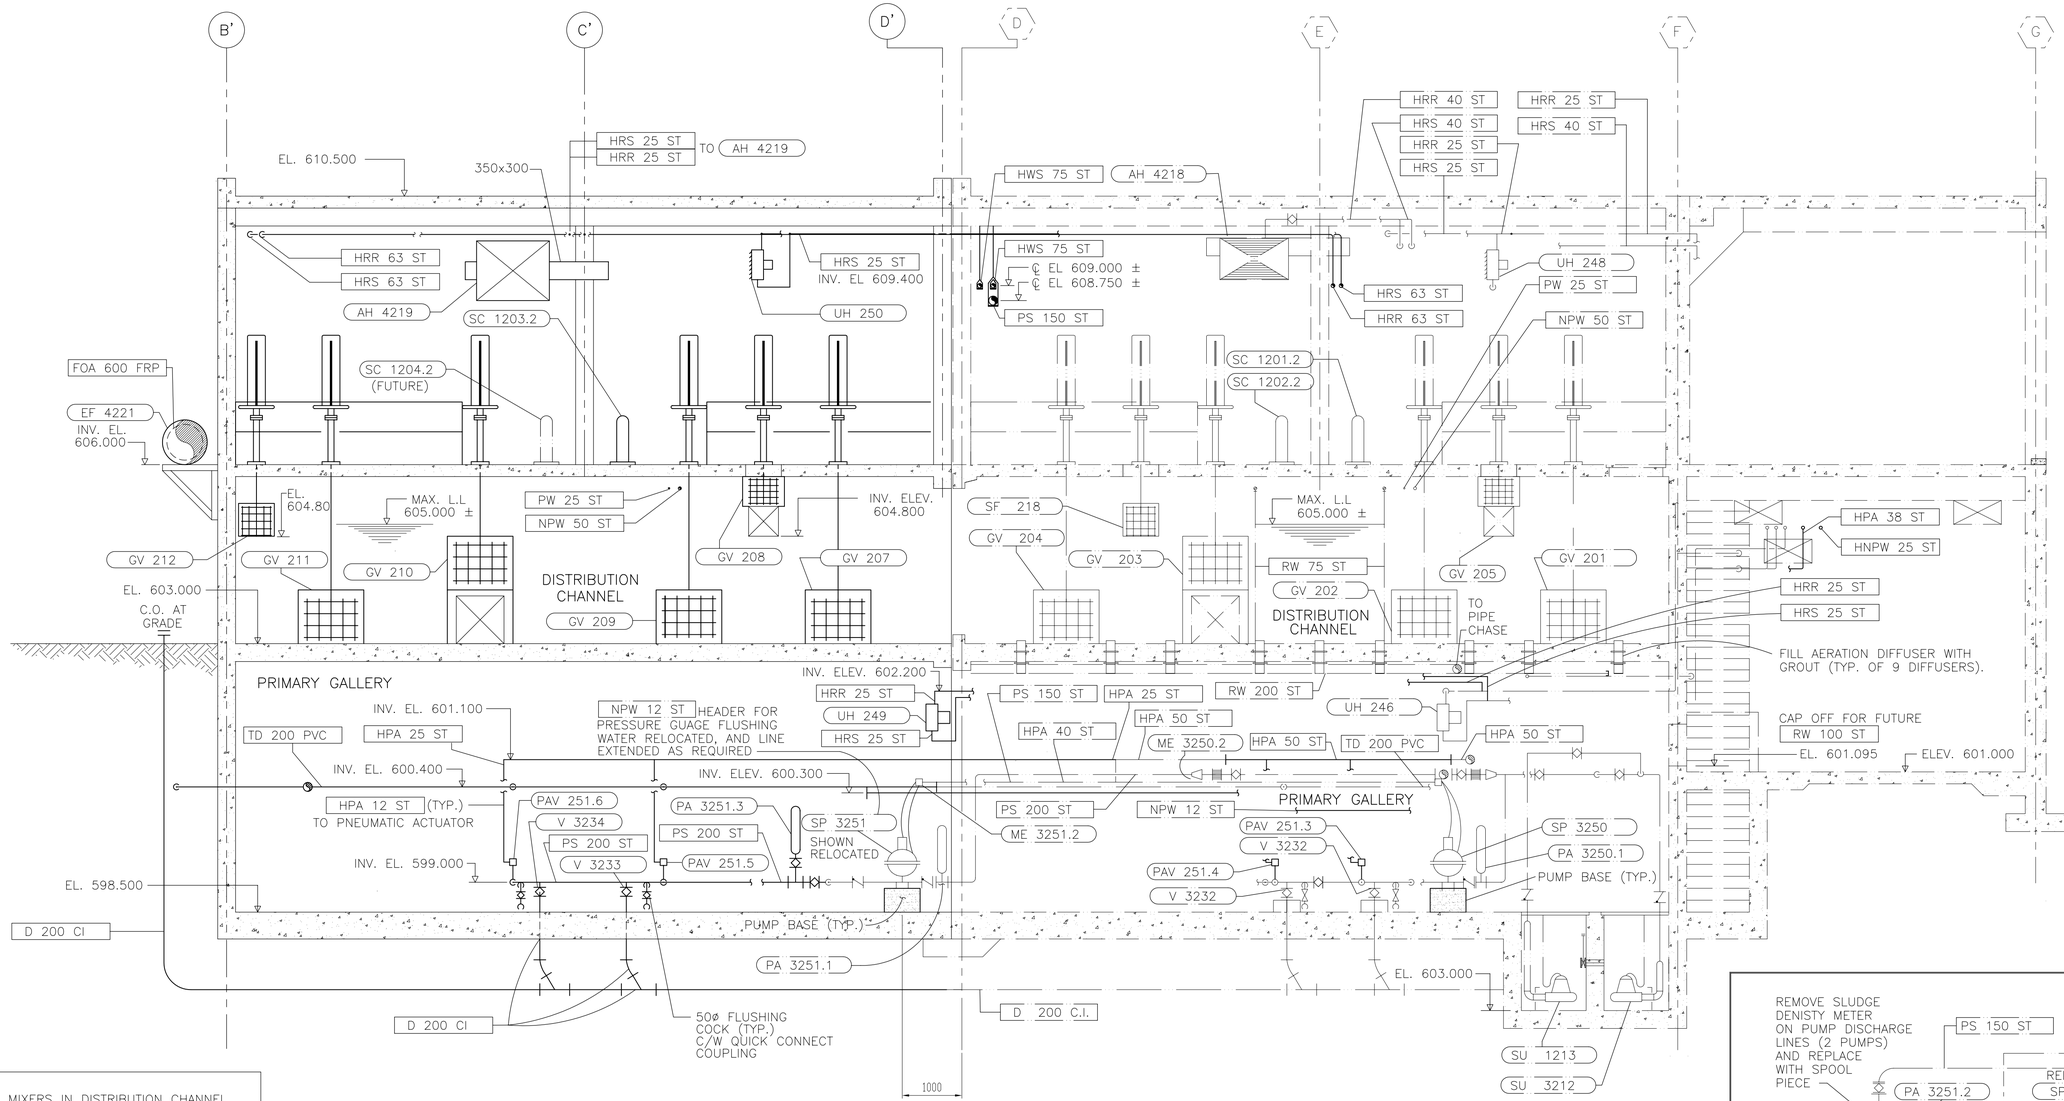

1. MIXERS IN DISTRIBUTION CHANNEL NOT SHOWN FOR CLARITY.
2. ALL REDUCERS ON SLUDGE LINES ARE OF THE ECCENTRIC TYPE.
3. ALL PLUG VALVES OVER 2.0m HIGH TO HAVE CHAINS AND CHAIN HOOKS.

SEE C / M203

SECTION 1/M207 1/M208 1/M201 1/M202

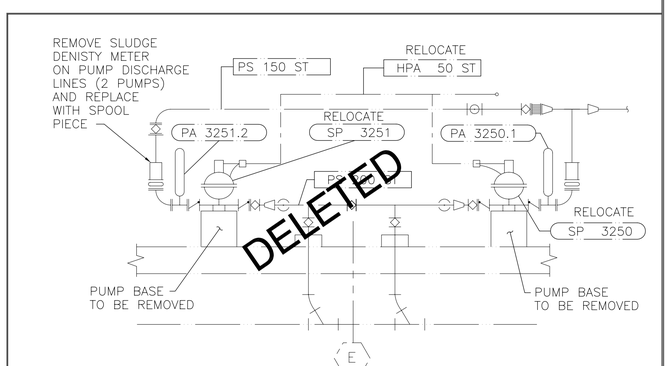

EXISTING SLUDGE PUMPS AND PIPING
(BEFORE RELOCATION)
1:50

ACAD DWG. M209 1:50 98-03-17

REVISIONS	ISSUE	DATE	DRAWN	CHK'D	APP'D	DESCRIPTION	ISSUE	DATE	DRAWN	CHK'D	APP'D	DESCRIPTION
	B	APR/96	LW	HK	HK	ISSUED FOR CONSTRUCTION						
	C	MAR/98	GSAM	R.W.	R.W.	RECORD DRAWING						

AutoCAD DRAWING

DESIGNED H.P.W.
DRAWN DK/ES
CHECKED HK

DAYTON & KNIGHT LTD.
Consulting Engineers

RESORT MUNICIPALITY OF WHISTLER
WASTEWATER TREATMENT PLANT–STAGE III EXPANSION–CONTRACT 1
PRIMARY SEDIMENTATION TANKS–SECTIONS

SCALE: 1:50
M209
DRAWING No. 179.11.1
SHEET 133 OF 249 ISSUE C