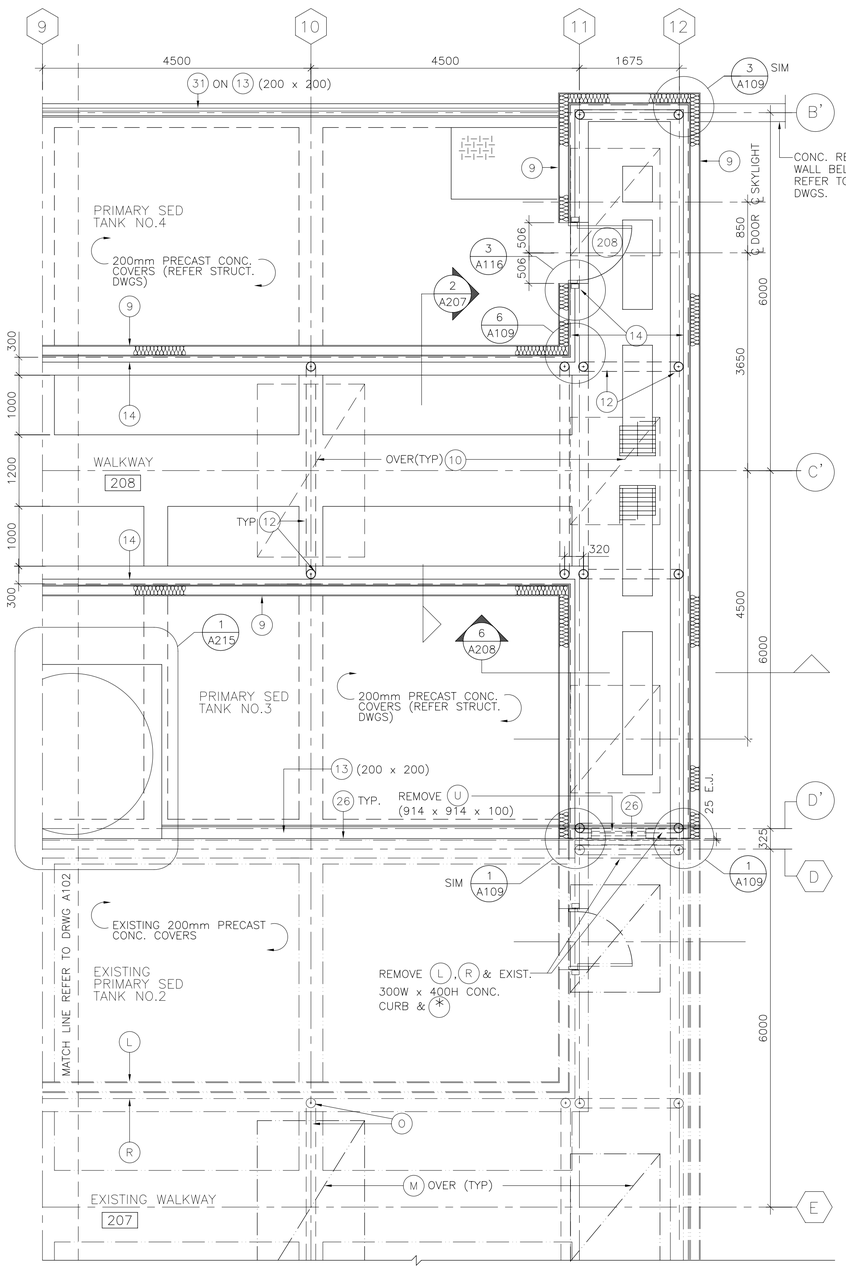

1 PARTIAL FLOOR PLAN @ EL.606.000
1:50

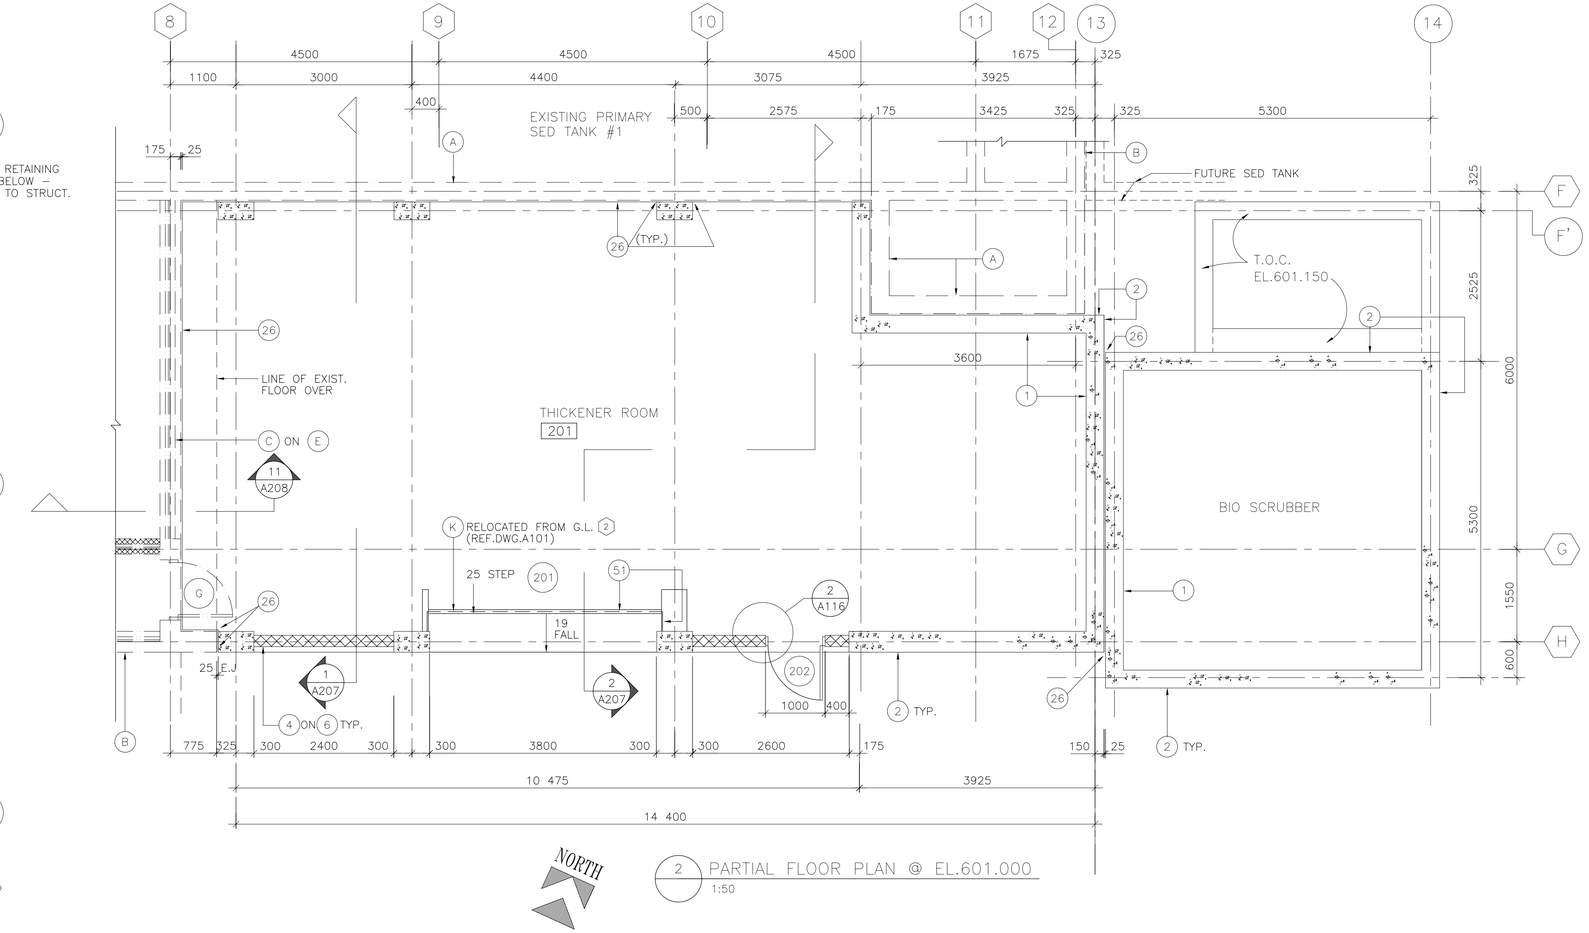

2 PARTIAL FLOOR PLAN @ EL.601.000
1:50

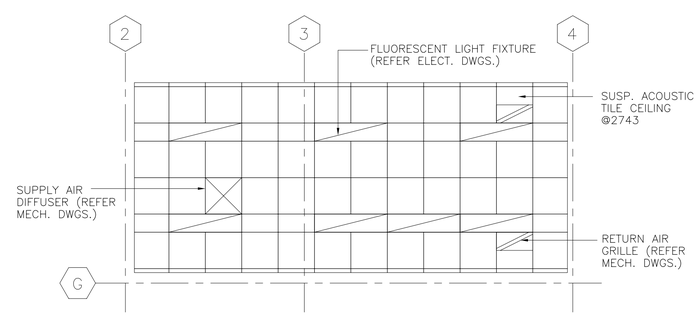

3 OFFICE/ELECT. WORKSHOP 116 RELECTED CEILING PLAN
1:50

NOTE REFERENCES:

EXISTING CONSTRUCTION

- (*) MAKE GOOD ALL EXPOSED/DISTURBED SURFACES
- (A) CONCRETE
- (B) SANDBLASTED CONCRETE
- (C) 256mm INSULATED 90mm CONCRETE BLOCK CAVITY WALL
- (E) 200H x 256W CONCRETE CURB
- (G) GLAZED METAL DOOR, FRAME & TRANSOM PANELS
- (K) VERTICAL LIFT DOOR
- (L) INSULATED PREFINISHED CORRUGATED STEEL CLADDING SYSTEM
- (M) CORRUGATED TRANSLUCENT SKYLIGHT PANEL
- (O) 168 ∅ HSS COLUMN
- (R) 127 x 76.2 H.S.S GIRT/OR DOOR POST
- (U) ALUM.WEATHER LOUVRE

NEW CONSTRUCTION

- (1) CONCRETE
- (2) SANDBLASTED CONCRETE
- (4) 190mm CONC. BLOCK
- (6) 200H x 190W CONC.CURB
- (9) INSULATED PREFINISHED CORRUGATED STEEL CLADDING SYSTEM(TO MATCH EXISTING)
- (10) CORRUGATED TRANSLUCENT SKYLIGHT PANEL
- (12) 168 ∅ H.S.S. COLUMN
- (13) CONC. CURB (W x H)
- (14) 127 x 76.2 H.S.S GIRT/OR DOOR POST
- (26) CONTINUOUS SEALANT & CAULKING
- (31) GALV. STEEL GUARDRAIL (REFER MECH. DWGS.)
- (51) CONTINUOUS 50 x 50 x 6mm EMBEDDED GALV. STEEL ANGLE. (LOCATE TO SUIT DOOR BOTTOM)

TOBY RUSSELL BUCKWELL
& partners architects
1650 ALBERNI STREET, VANCOUVER, B.C.
CANADA, V6G 1B1. TEL.: [604] 682-6881
FAX: [604] 682-3081

ACAD DWG. A103 1:50 96-04-24

AutoCAD DRAWING

REVISIONS

ISSUE	DATE	DRAWN	CHK'D	APP'D	DESCRIPTION	ISSUE	DATE	DRAWN	CHK'D	APP'D	DESCRIPTION
B	APR/96	E.S.	C.O.	C.O.	ISSUED FOR CONSTRUCTION						

DESIGNED D.K.M.
DRAWN B.D.C.
CHECKED C.O.

DAYTON & KNIGHT LTD.
Consulting Engineers

RESORT MUNICIPALITY OF WHISTLER
WASTEWATER TREATMENT PLANT–STAGE III EXPANSION – CONTRACT 1
HEADWORKS & PRIMARY SED. TANKS
PLANS

SCALE: 1:50
A103/A203
DRAWING No. 179.11.1
SHEET 44 OF 249 ISSUE B