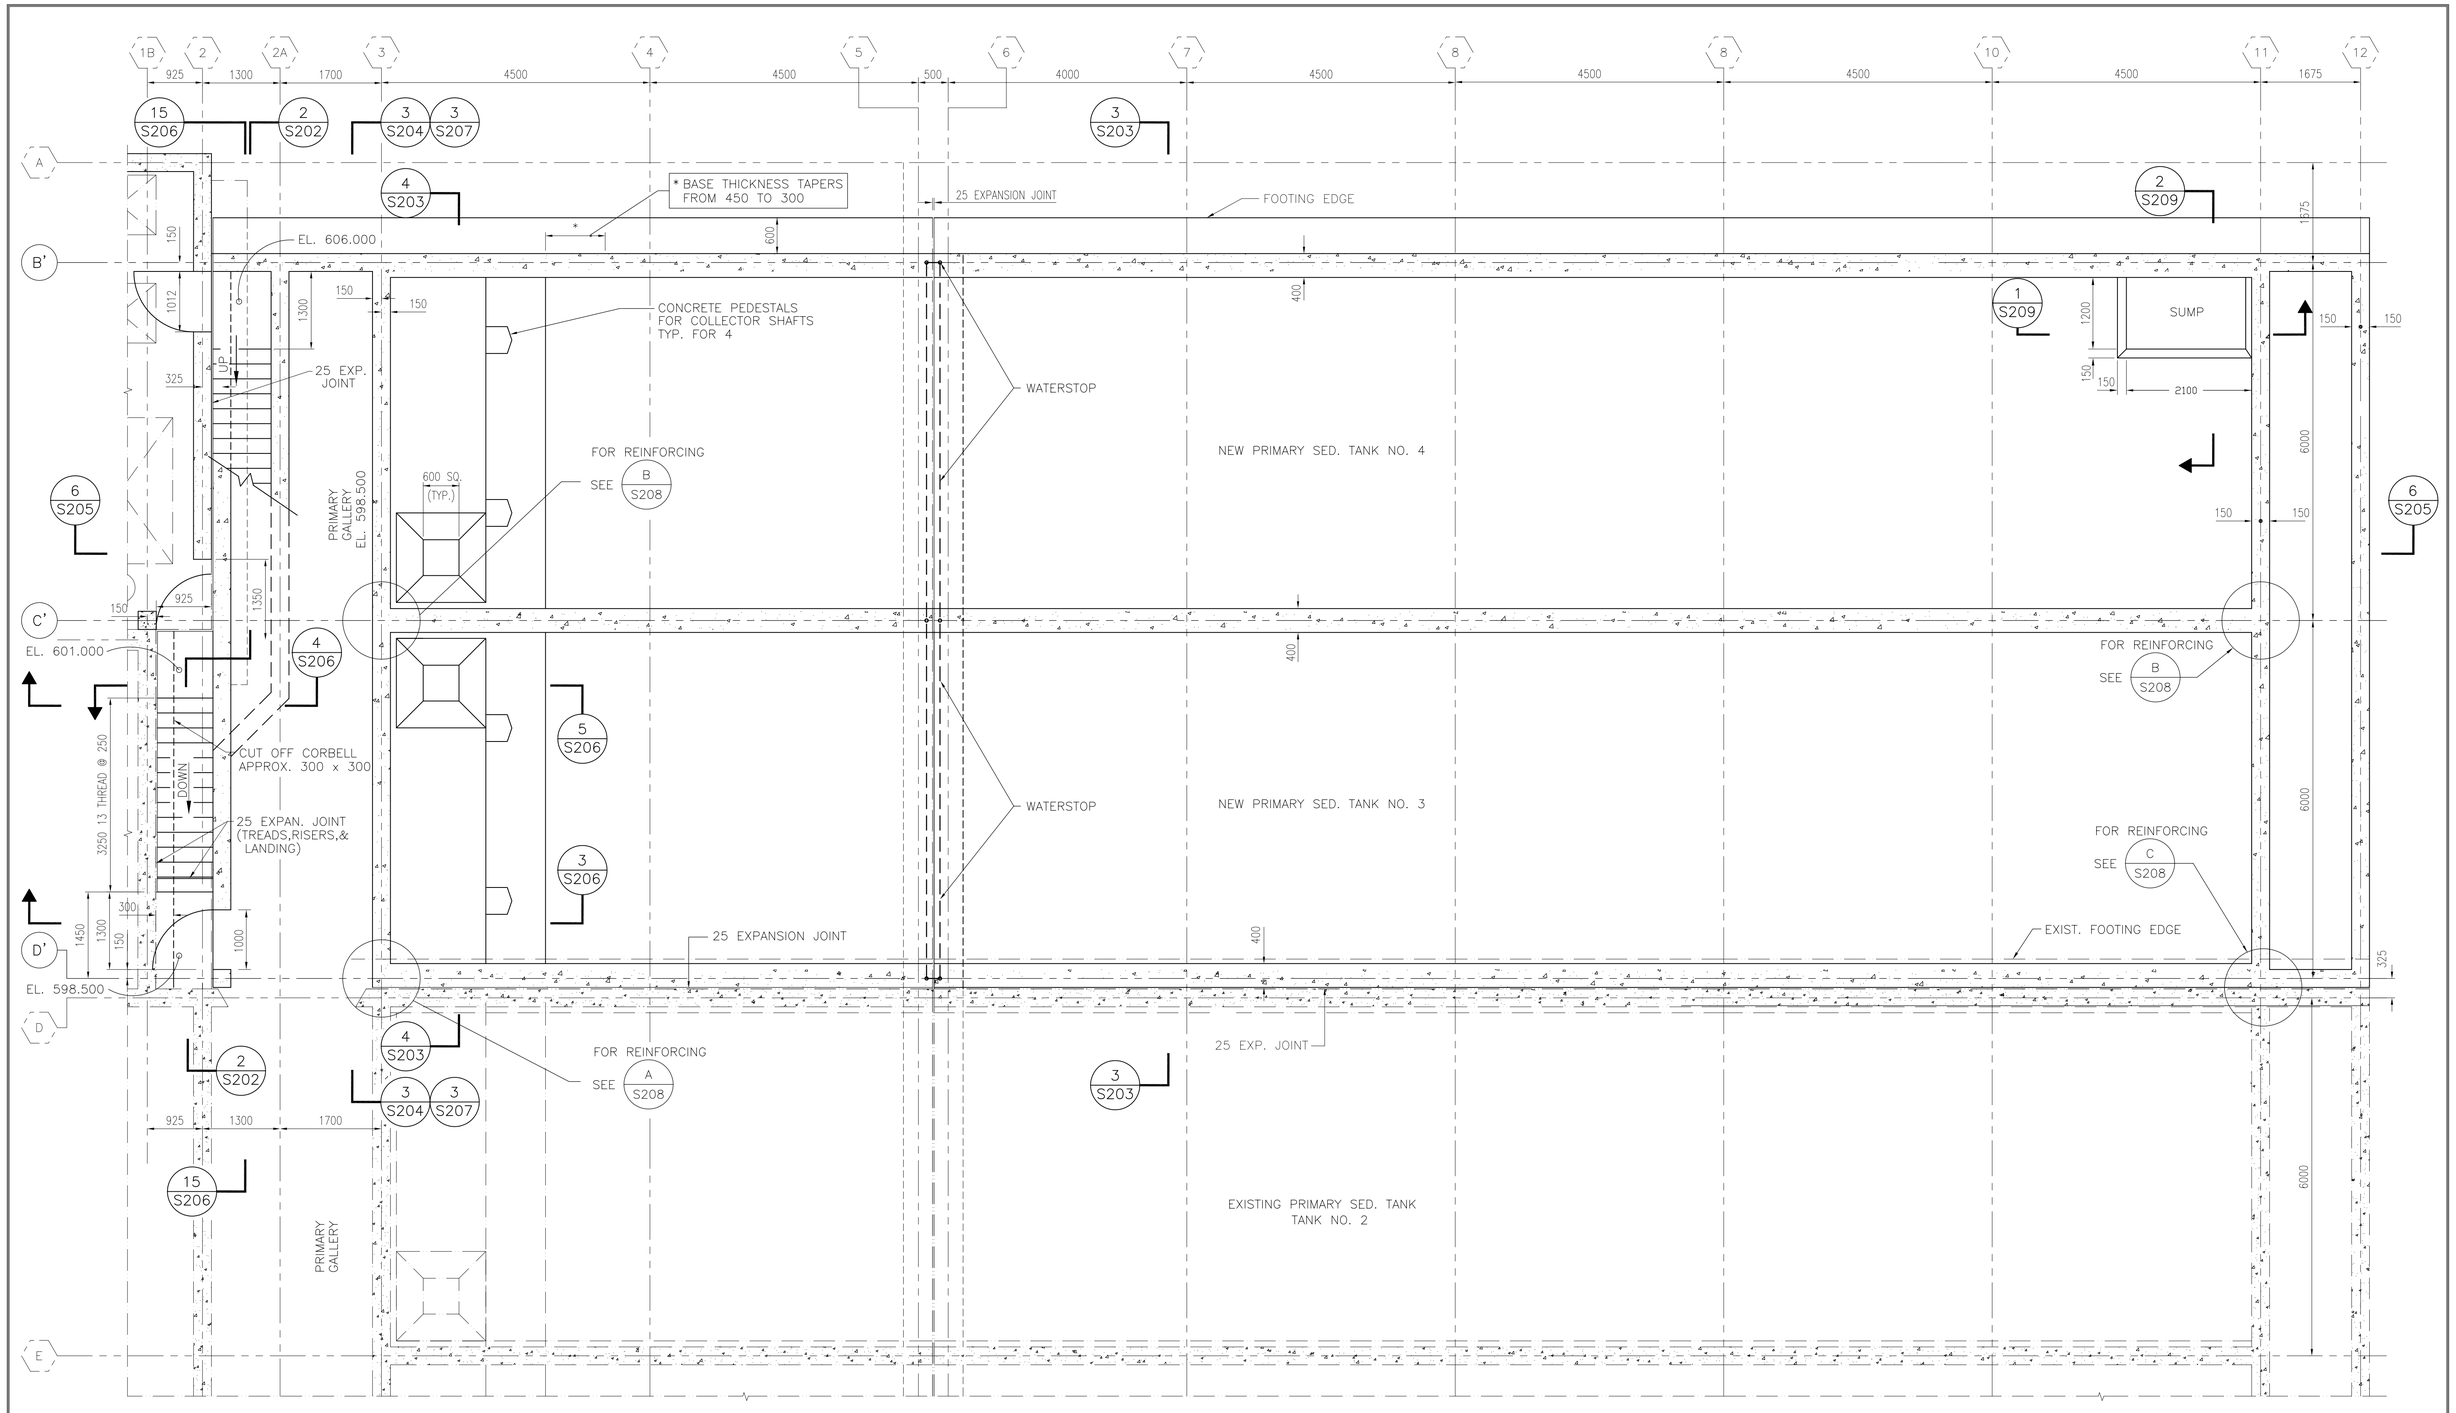

PLAN @ ELEV. 601.00/598.50

ACAD DWG. S201 1:50 98-02-17

AutoCAD DRAWING

REVISIONS

ISSUE	DATE	DRAWN	CHK'D	APP'D	DESCRIPTION	ISSUE	DATE	DRAWN	CHK'D	APP'D	DESCRIPTION
B	APR/96	DBC	H.K.	H.K.	ISSUED FOR CONSTRUCTION						
C	JAN/98	JC			RECORD DRAWING						

DESIGNED H.K.
DRAWN WSL/KM/SL
CHECKED H.K.

DAYTON & KNIGHT LTD.
Consulting Engineers

RESORT MUNICIPALITY OF WHISTLER
WASTEWATER TREATMENT PLANT–STAGE III EXPANSION–CONTRACT 1
PRIMARY SED. TANKS–PLAN @ EL. 601.000–CONCRETE OUTLINE

SCALE: 1:50 S201
DRAWING No. 179.11.1
SHEET 75 OF 249 ISSUE C