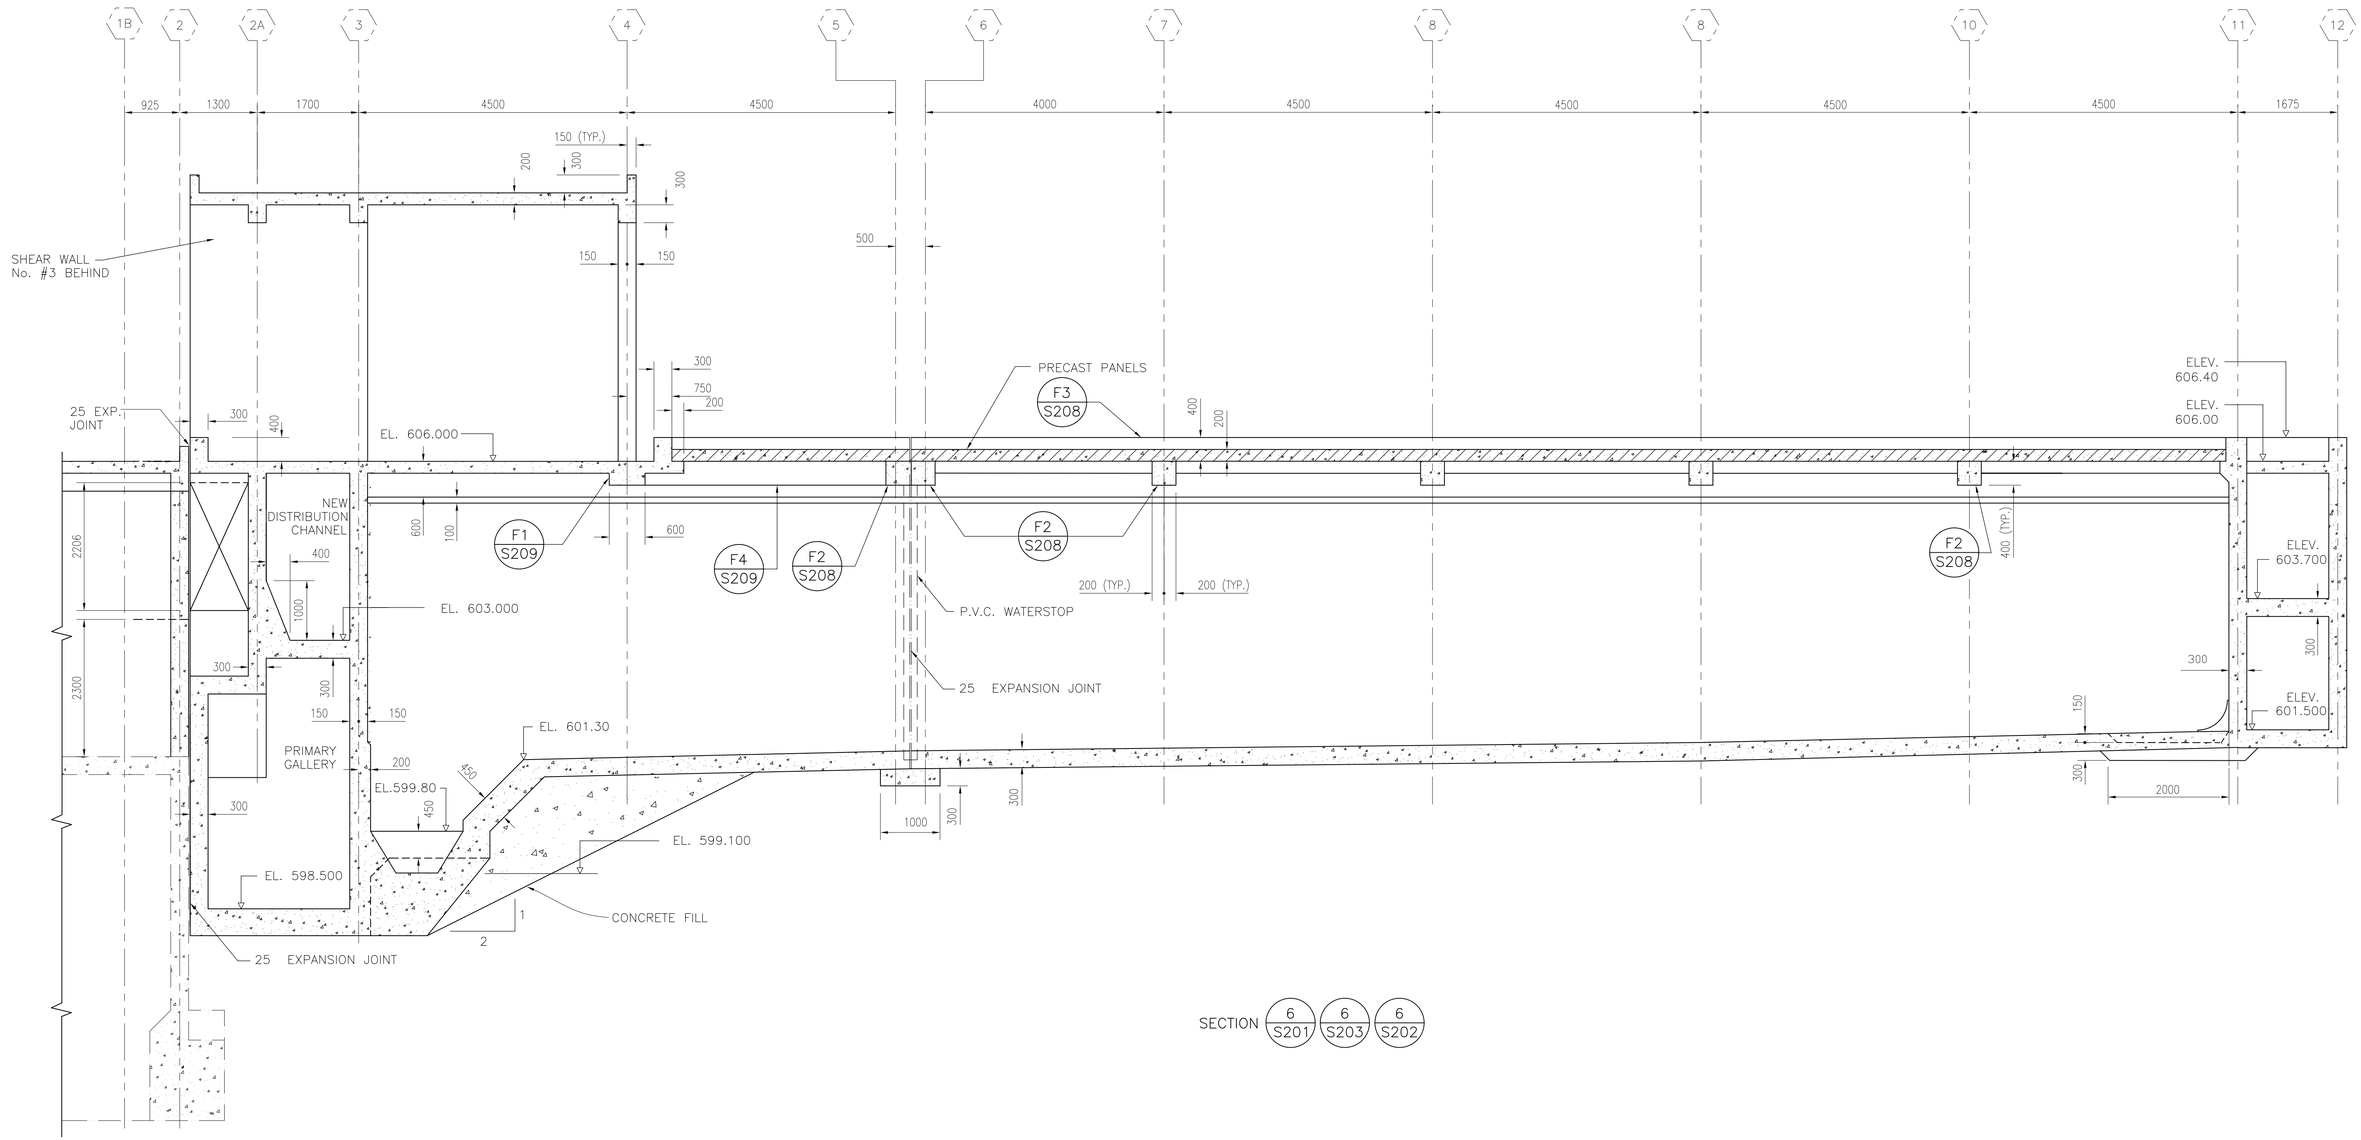

SECTION 6/S201 6/S203 6/S202

ACAD DWG. S205 1:50 98-01-26

AutoCAD DRAWING REVISIONS	ISSUE	DATE	DRAWN	CHK'D	APP'D	DESCRIPTION	ISSUE	DATE	DRAWN	CHK'D	APP'D	DESCRIPTION
	B	APR/96	DBC	R.W.	R.W.	ISSUED FOR CONSTRUCTION						
	C	JAN/98	JC			RECORD DRAWING						

DESIGNED R.W.
DRAWN WSL/K.M
CHECKED H.K.

DAYTON & KNIGHT LTD.
Consulting Engineers

RESORT MUNICIPALITY OF WHISTLER
WASTE WATER TREATMENT PLANT–STAGE III EXPANSION–CONTRACT 1
NEW PRIMARY SEDIMENTATION TANKS – SECTION

SCALE: 1:50
S205
DRAWING No. 179.11.1
SHEET 79 OF 249 ISSUE C