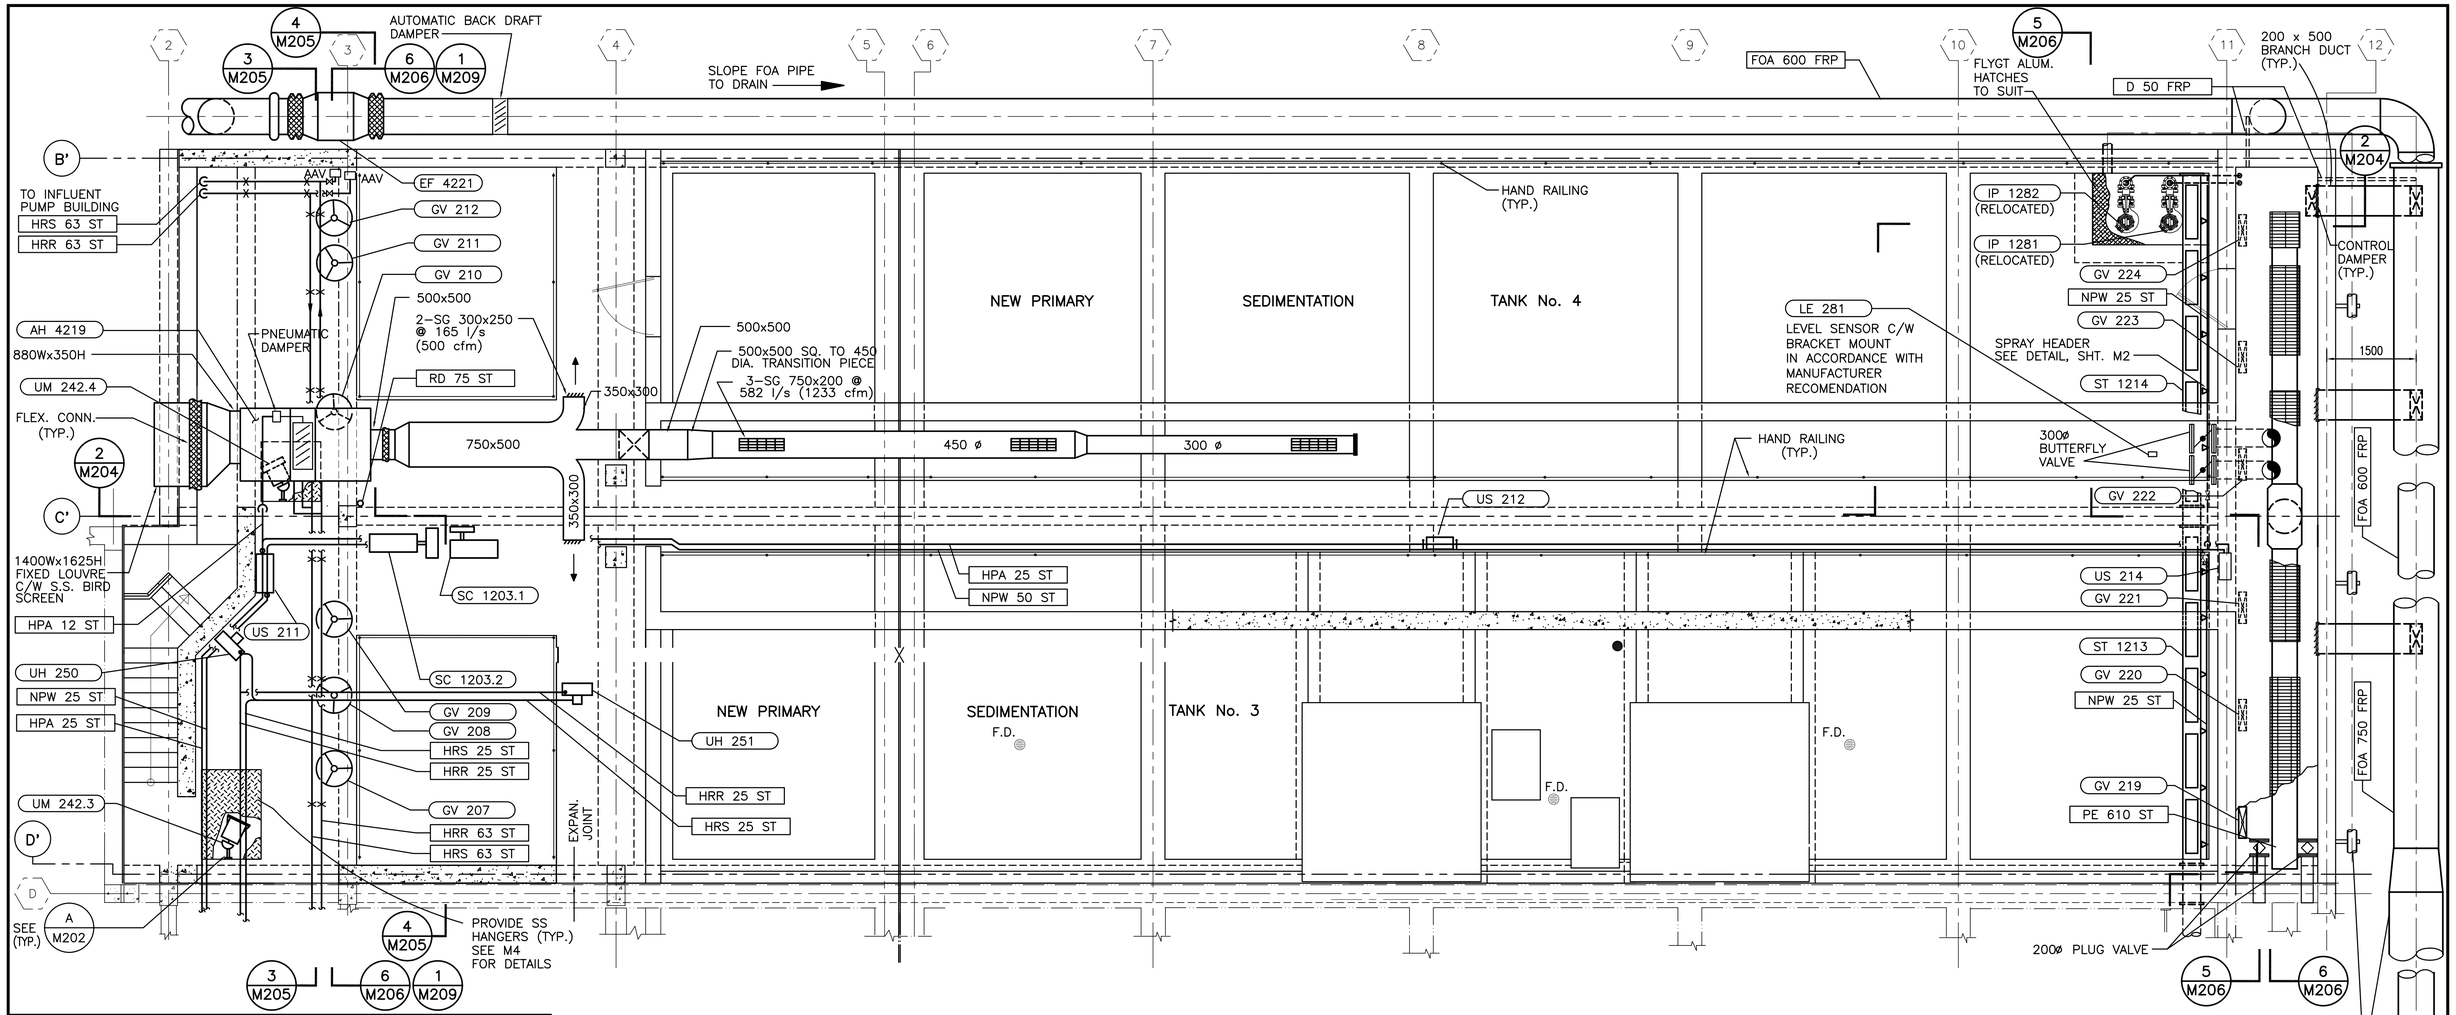

PLAN @ EL. 610.000
1:50

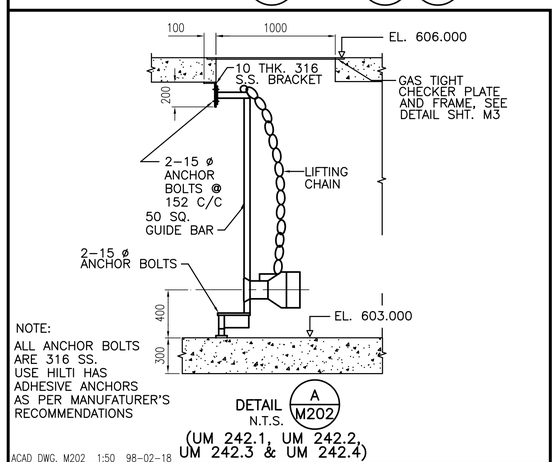

NOTE:
ALL ANCHOR BOLTS ARE 316 SS.
USE HILTI HAS ADHESIVE ANCHORS AS PER MANUFATURER'S RECOMMENDATIONS

DETAIL A/M202
N.T.S.
(UM 242.1, UM 242.2, UM 242.3 & UM 242.4)

ACAD DWG. M202 1:50 98-02-18

AutoCAD DRAWING REVISIONS	ISSUE	DATE	DRAWN	CHK'D	APP'D	DESCRIPTION	ISSUE	DATE	DRAWN	CHK'D	APP'D	DESCRIPTION
	B	APR/96	LW	HK	HK	ISSUED FOR CONSTRUCTION						
	C	FEB/98	JC			RECORD DRAWING						

DESIGNED HPW/RW
DRAWN GS/LW/ES
CHECKED HK

DAYTON & KNIGHT LTD.
Consulting Engineers

RESORT MUNICIPALITY OF WHISTLER
WASTEWATER TREATMENT PLANT–STAGE III EXPANSION–CONTRACT 1
PRIMARY SEDIMENTATION TANKS – PLAN @ EL. 610.000

SCALE: 1:50
M202
DRAWING No. 179.11.1
SHEET 126 OF 249 ISSUE C