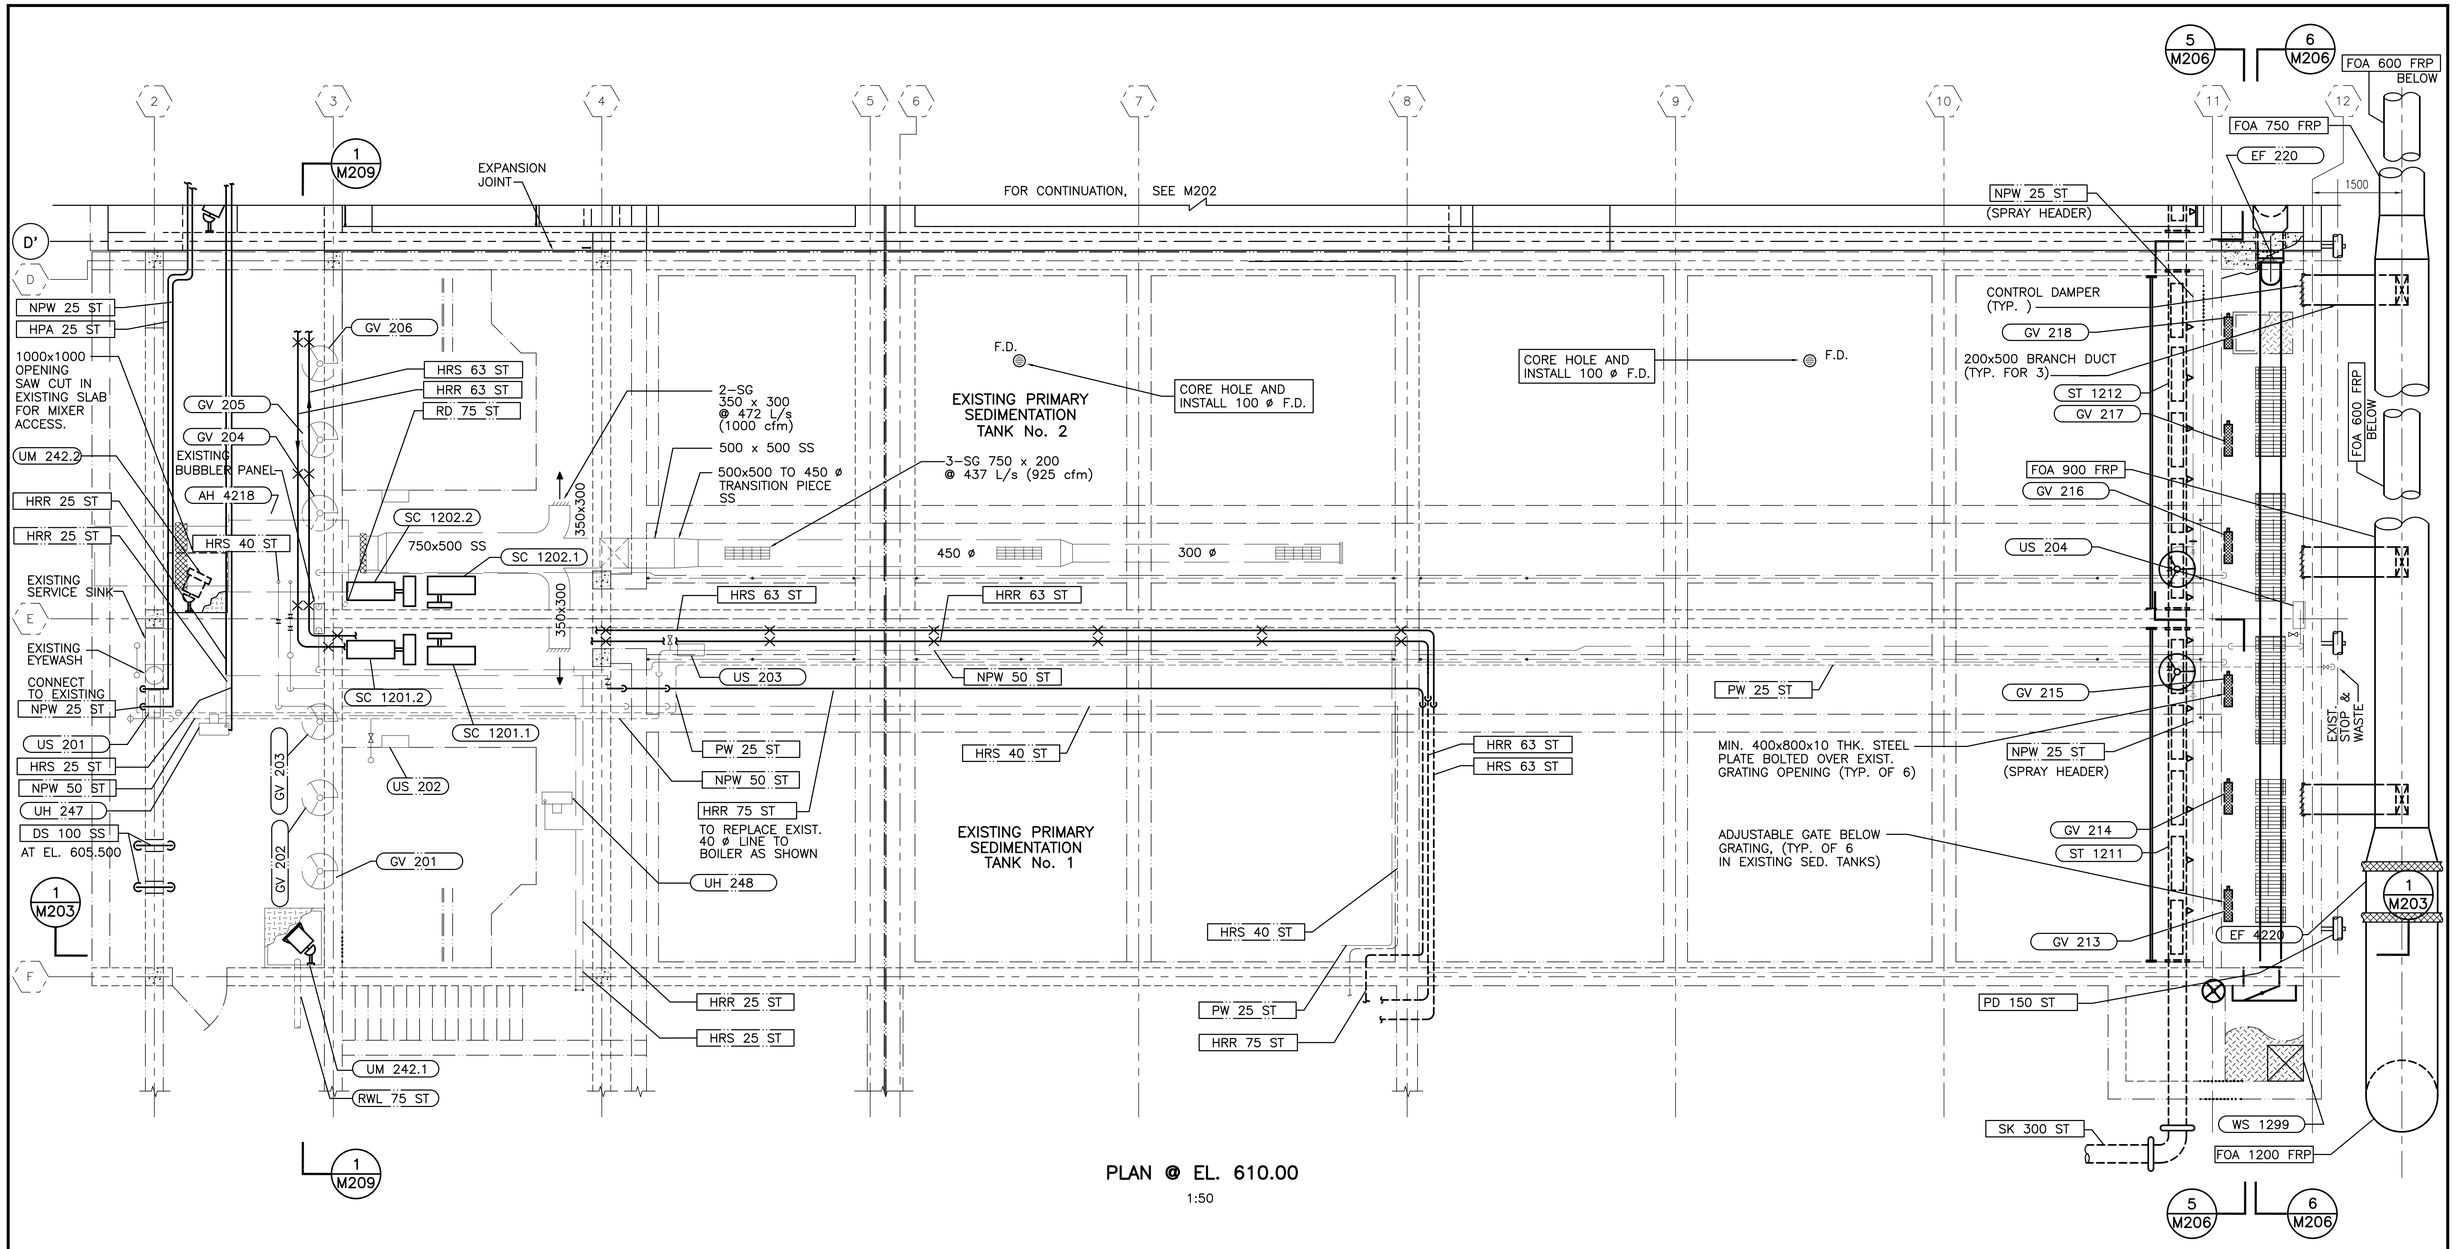

PLAN @ EL. 610.00

1:50

NOTE:

REMOVED SIX EXISTING SLIDE PLATES AND FRAMES IN EXISTING PRIMARY SED. TANKS AND REPLACE WITH SLIDE GATES GV 201 THROUGH GV 206 AS SHOWN.

ACAD DWG. M201 1:50 98-02-18

AutoCAD DRAWING

REVISIONS

ISSUE	DATE	DRAWN	CHK'D	APP'D	DESCRIPTION
B	APR/96	LW	HK	HK	ISSUED FOR CONSTRUCTION
C	FEB/98	JC			RECORD DRAWING

ISSUE	DATE	DRAWN	CHK'D	APP'D	DESCRIPTION

DESIGNED H.P.W.
DRAWN WSL/LW/ES
CHECKED HK

DAYTON & KNIGHT LTD.
Consulting Engineers

RESORT MUNICIPALITY OF WHISTLER
WASTEWATER TREATMENT PLANT–STAGE III EXPANSION–CONTRACT 1
PRIMARY SEDIMENTATION TANKS PLAN @ EL. 610.000

SCALE: 1:50

M201

DRAWING No. 179.11.1
SHEET 125 OF 249 ISSUE C