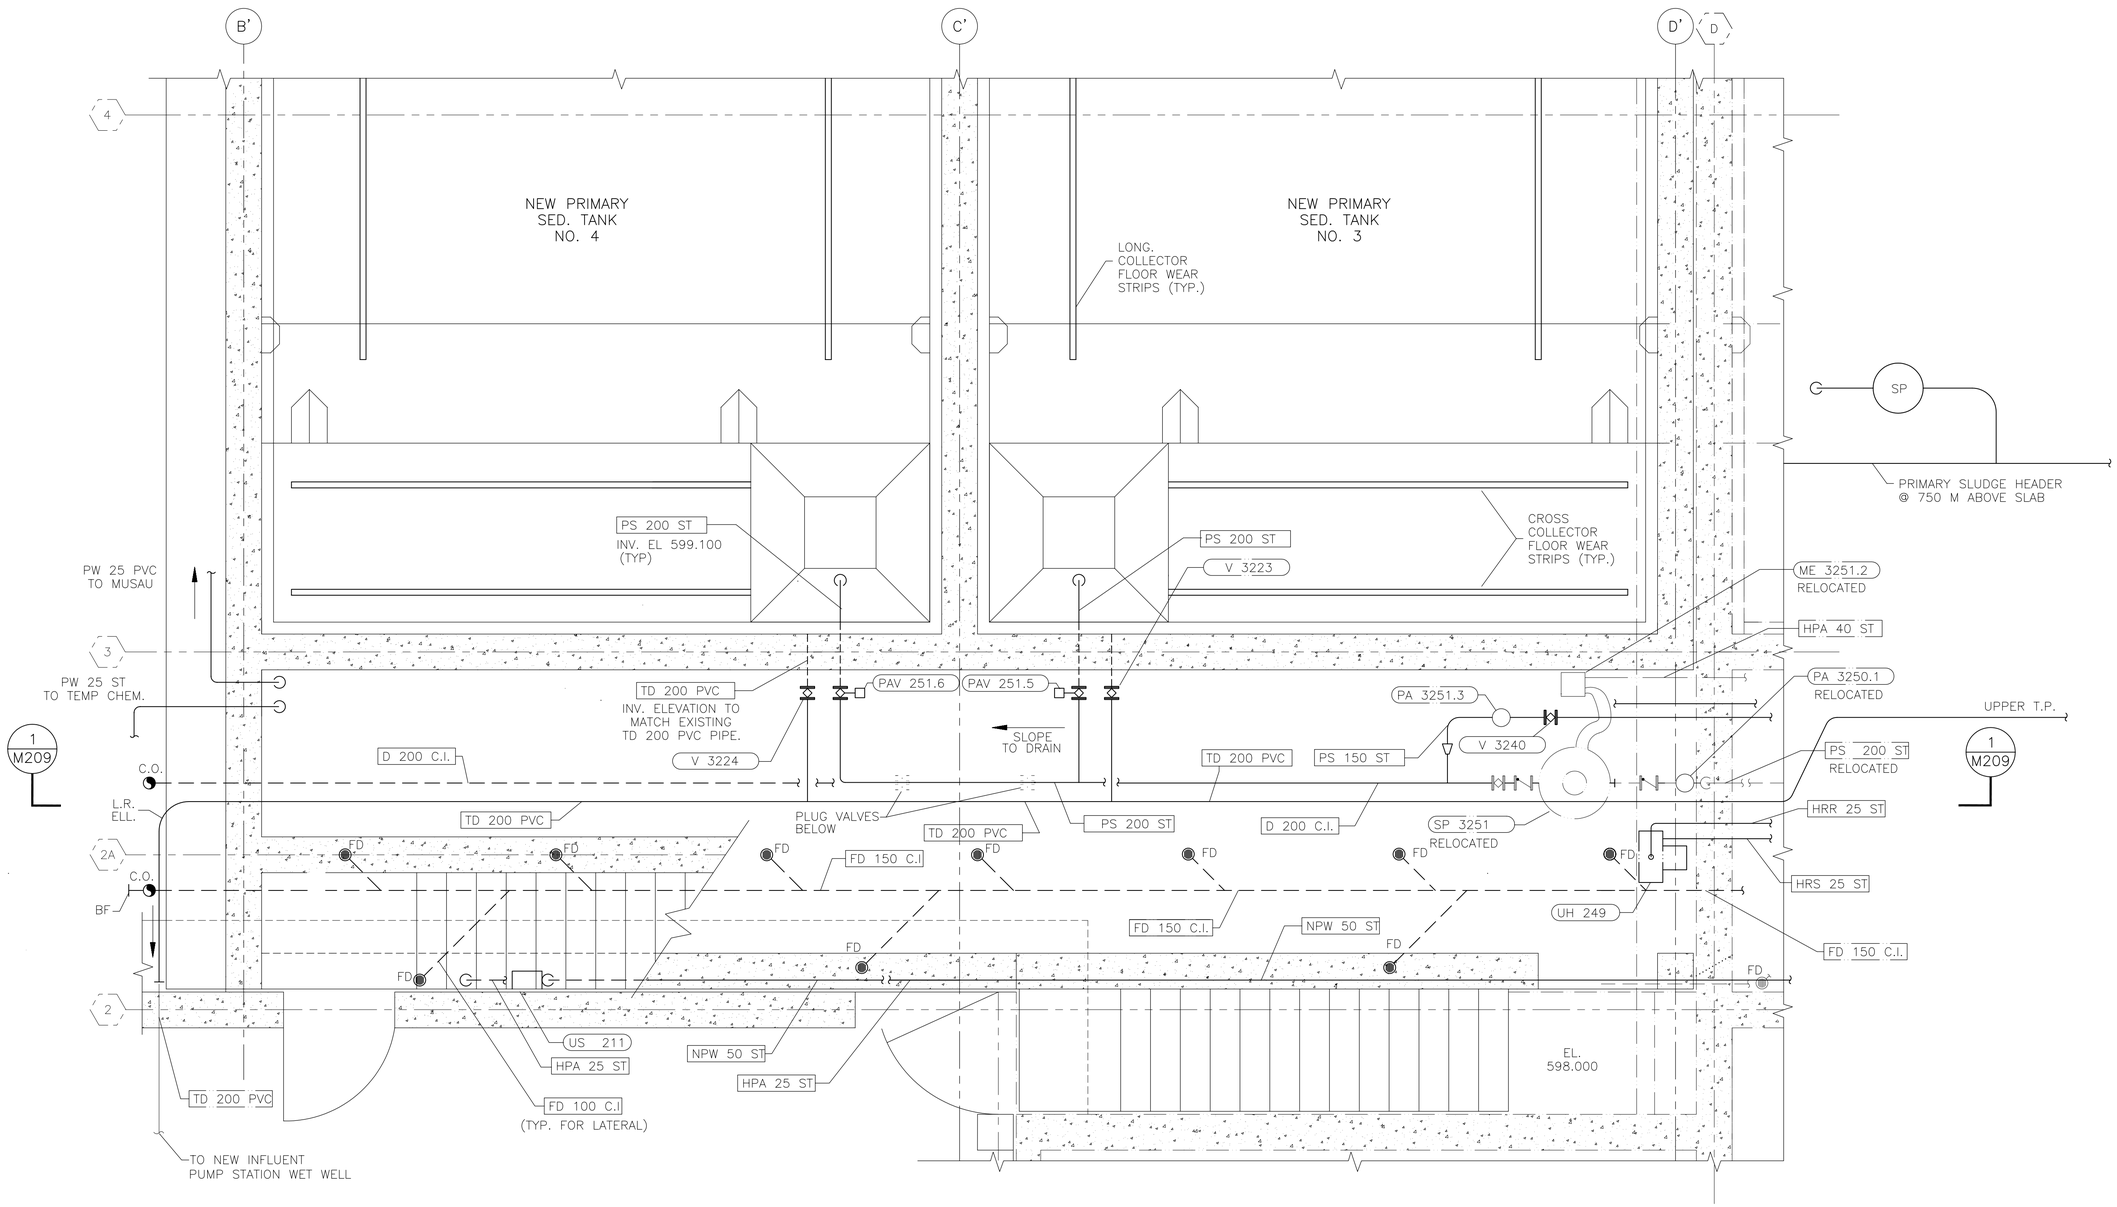

PLAN @ EL. 602.500

1:25

ACAD DWG. M208 1:25 98-03-19

AutoCAD DRAWING REVISIONS	ISSUE	DATE	DRAWN	CHK'D	APP'D	DESCRIPTION	ISSUE	DATE	DRAWN	CHK'D	APP'D	DESCRIPTION
	B	APR/96	LW	HK	HK	ISSUED FOR CONSTRUCTION						
	C	MAR/98	GSAM	R.W.	R.W.	RECORD DRAWING						

DESIGNED H.P.W.
DRAWN WSL/GS
CHECKED HK

DAYTON & KNIGHT LTD.
Consulting Engineers

RESORT MUNICIPALITY OF WHISTLER
WASTEWATER TREATMENT PLANT–STAGE III EXPANSION–CONTRACT 1
PRIMARY SED. TANKS–PARTIAL PLAN @ EL. 602.500

SCALE: 1:25 M208
DRAWING No. 179.11.1
SHEET 132 OF 249 ISSUE C