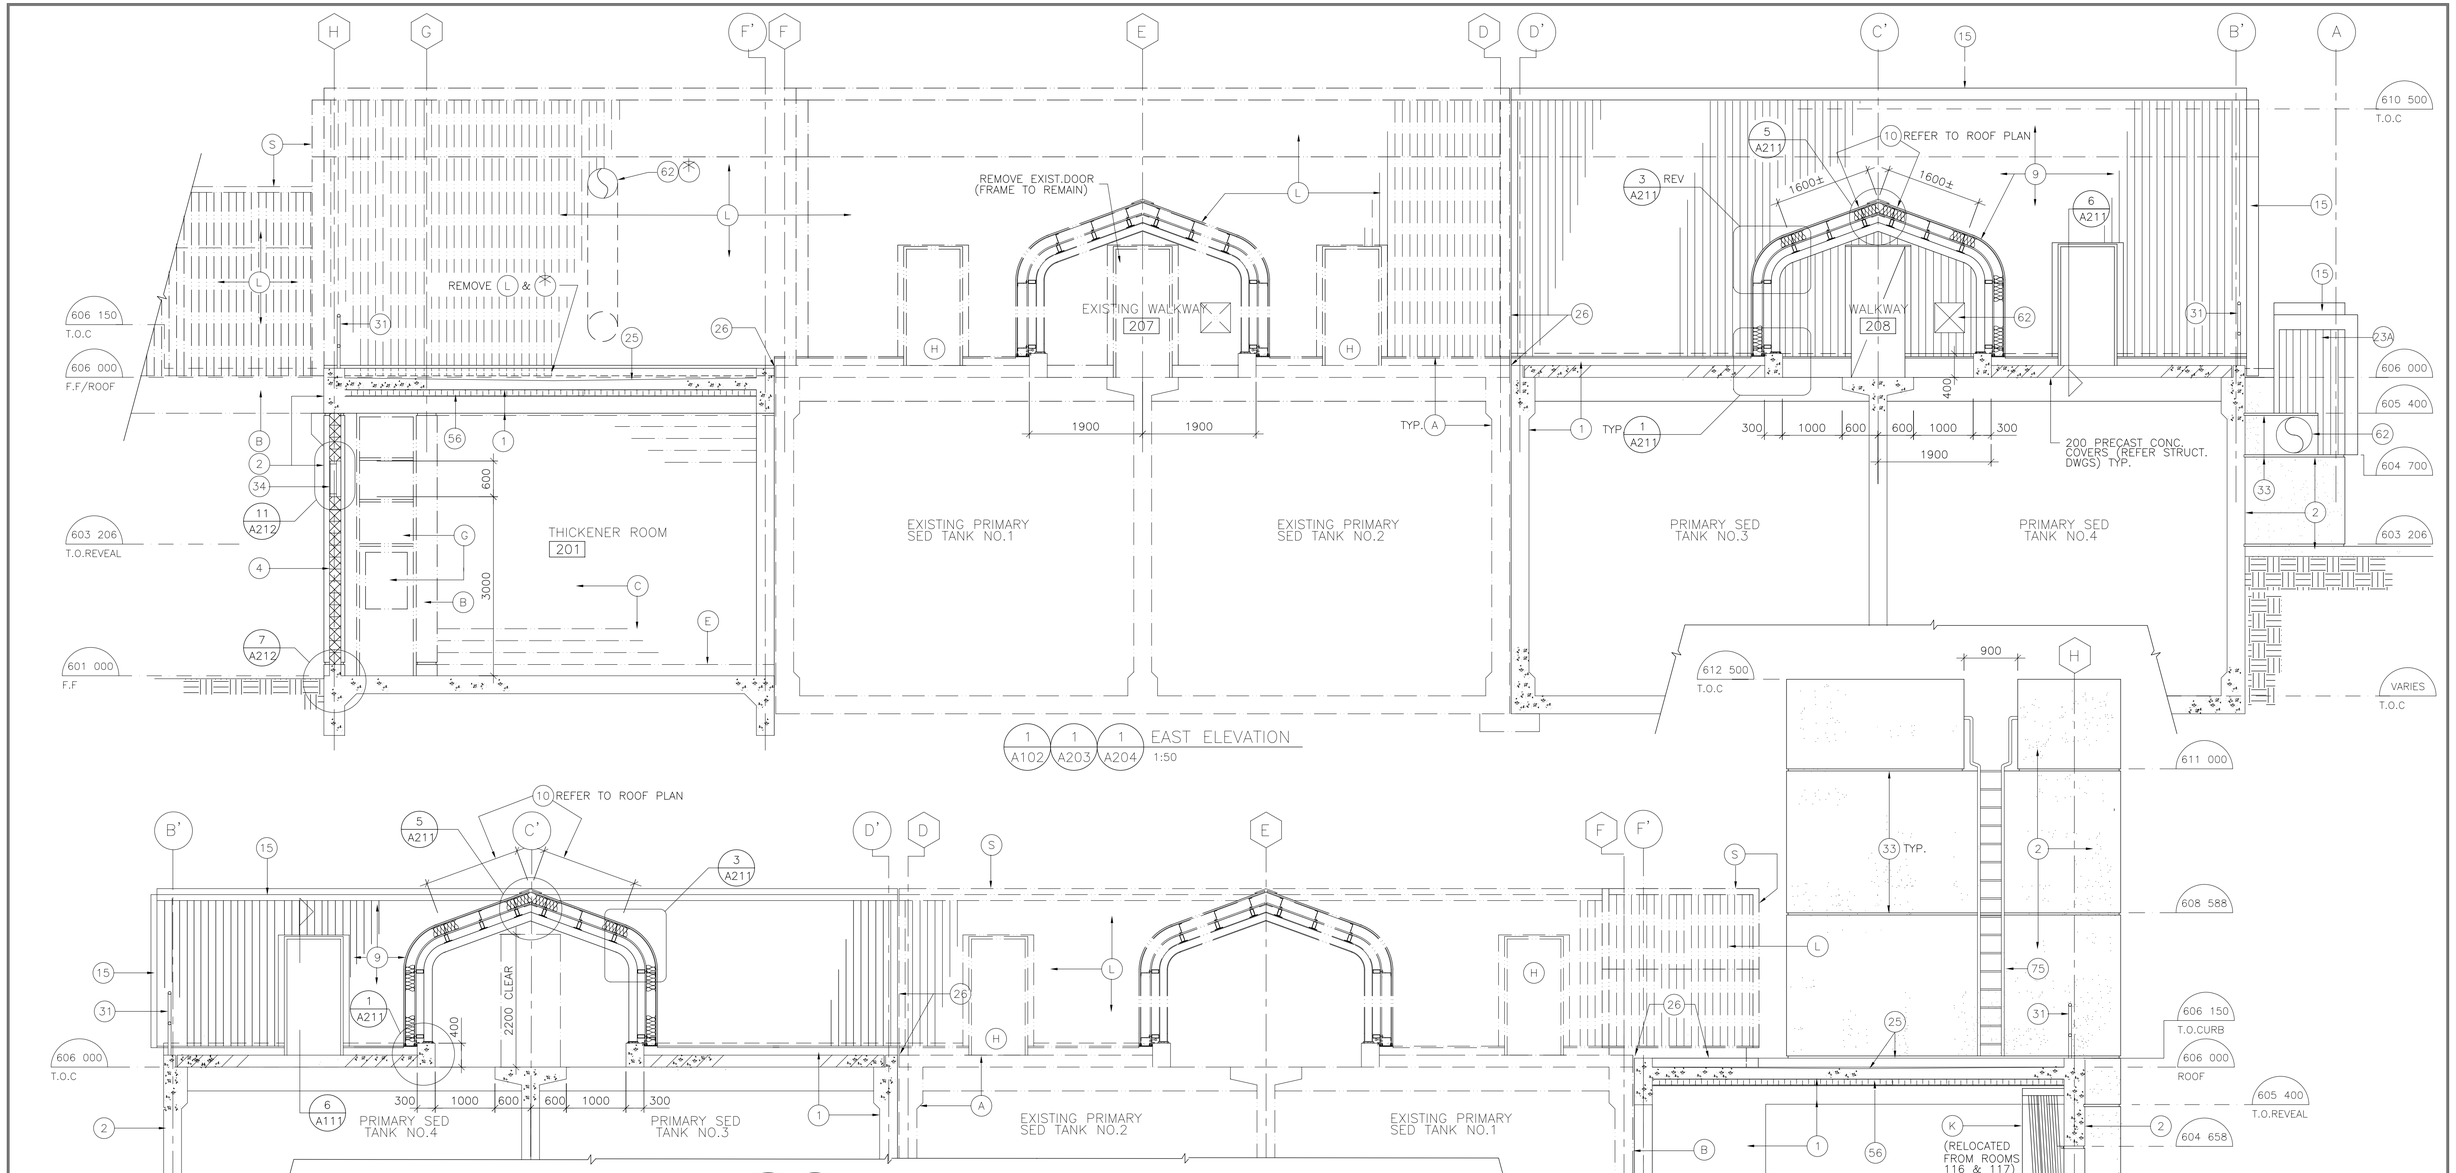

1 A102 1 A203 1 A204 EAST ELEVATION 1:50

2 A203 2 A204 WEST ELEVATION 1:50

NOTE REFERENCES:

EXISTING CONSTRUCTION

- (*) MAKE GOOD ALL EXPOSED/DISTURBED SURFACES
- (A) CONCRETE
- (B) SANDBLASTED CONCRETE
- (C) 256mm INSULATED 90mm CONCRETE BLOCK CAVITY WALL
- (E) 200H x 256W CONCRETE CURB
- (G) GLAZED METAL DOOR, FRAME, & TRANSOM PANELS
- (H) METAL DOOR & FRAME
- (K) VERTICAL LIFT DOOR
- (L) INSULATED PREFINISHED CORRUGATED STEEL CLADDING SYSTEM
- (S) PREFINISHED STEEL FLASHING

NEW CONSTRUCTION

- (1) CONCRETE
- (2) SANDBLASTED CONCRETE
- (4) 190mm CONC. BLOCK
- (9) INSULATED PREFINISHED CORRUGATED STEEL CLADDING SYSTEM(TO MATCH EXISTING)
- (10) CORRUGATED TRANSLUCENT SKYLIGHT PANEL
- (15) PREFINISHED STEEL FLASHING(BY CLADDING SUPPLIER)
- (23A) PREFINISHED CORRUGATED STEEL CLADDING ON 1.22mm G90 GALV. SPLIT 'Z' SUB-GIRTS
- (25) CONCRETE SURFACE SEALER(REFER STRUCTURAL SPEC.)
- (26) CONTINUOUS SEALANT & BACK-UP ROD
- (31) GALV. STEEL GUARDRAIL (REFER MECH. DWGS.)
- (33) 19 x 19mm RUSTICATION (TO MATCH EXISTING)
- (34) ALUM. WEATHER LOUVRE (W x H x D) (PAINT TO MATCH COLOUR OF ADJ. WALL FINISH)
- (35) 100 x 100 x 1200 LG.GALV. STEEL BUMPER ANGLE
- (56) 13mm W.P.GYPSUM BOARD ON 100mm RIGID INSULATION (THERMO-STUD ANCHORED)
- (62) SHEET METAL DUCT (REFER TO MECH. DWGS)
- (75) GALV. STEEL ACCESS LADDER (REFER MECH. DWGS.)

TOBY RUSSELL BUCKWELL & partners architects
1650 ALBERNI STREET, VANCOUVER, B.C.
CANADA, V6G 1B1. TEL.: [604] 682-6881
FAX: [604] 682-3081

ACAD DWG. A107 1:50 96-04-24

AutoCAD DRAWING REVISIONS	ISSUE	DATE	DRAWN	CHK'D	APP'D	DESCRIPTION	ISSUE	DATE	DRAWN	CHK'D	APP'D	DESCRIPTION
	B	APR/96	E.S.	C.O.	C.O.	ISSUED FOR CONSTRUCTION						

DESIGNED D.K.M.
DRAWN B.D.C.
CHECKED C.O.

DAYTON & KNIGHT LTD.
Consulting Engineers

RESORT MUNICIPALITY OF WHISTLER
WASTEWATER TREATMENT PLANT–STAGE III EXPANSION – CONTRACT 1
HEADWORKS & PRIMARY SED. TANKS
EAST & WEST ELEVATION

SCALE: 1:50
A107/A207
DRAWING No. 179.11.1
SHEET 48 OF 249 ISSUE B