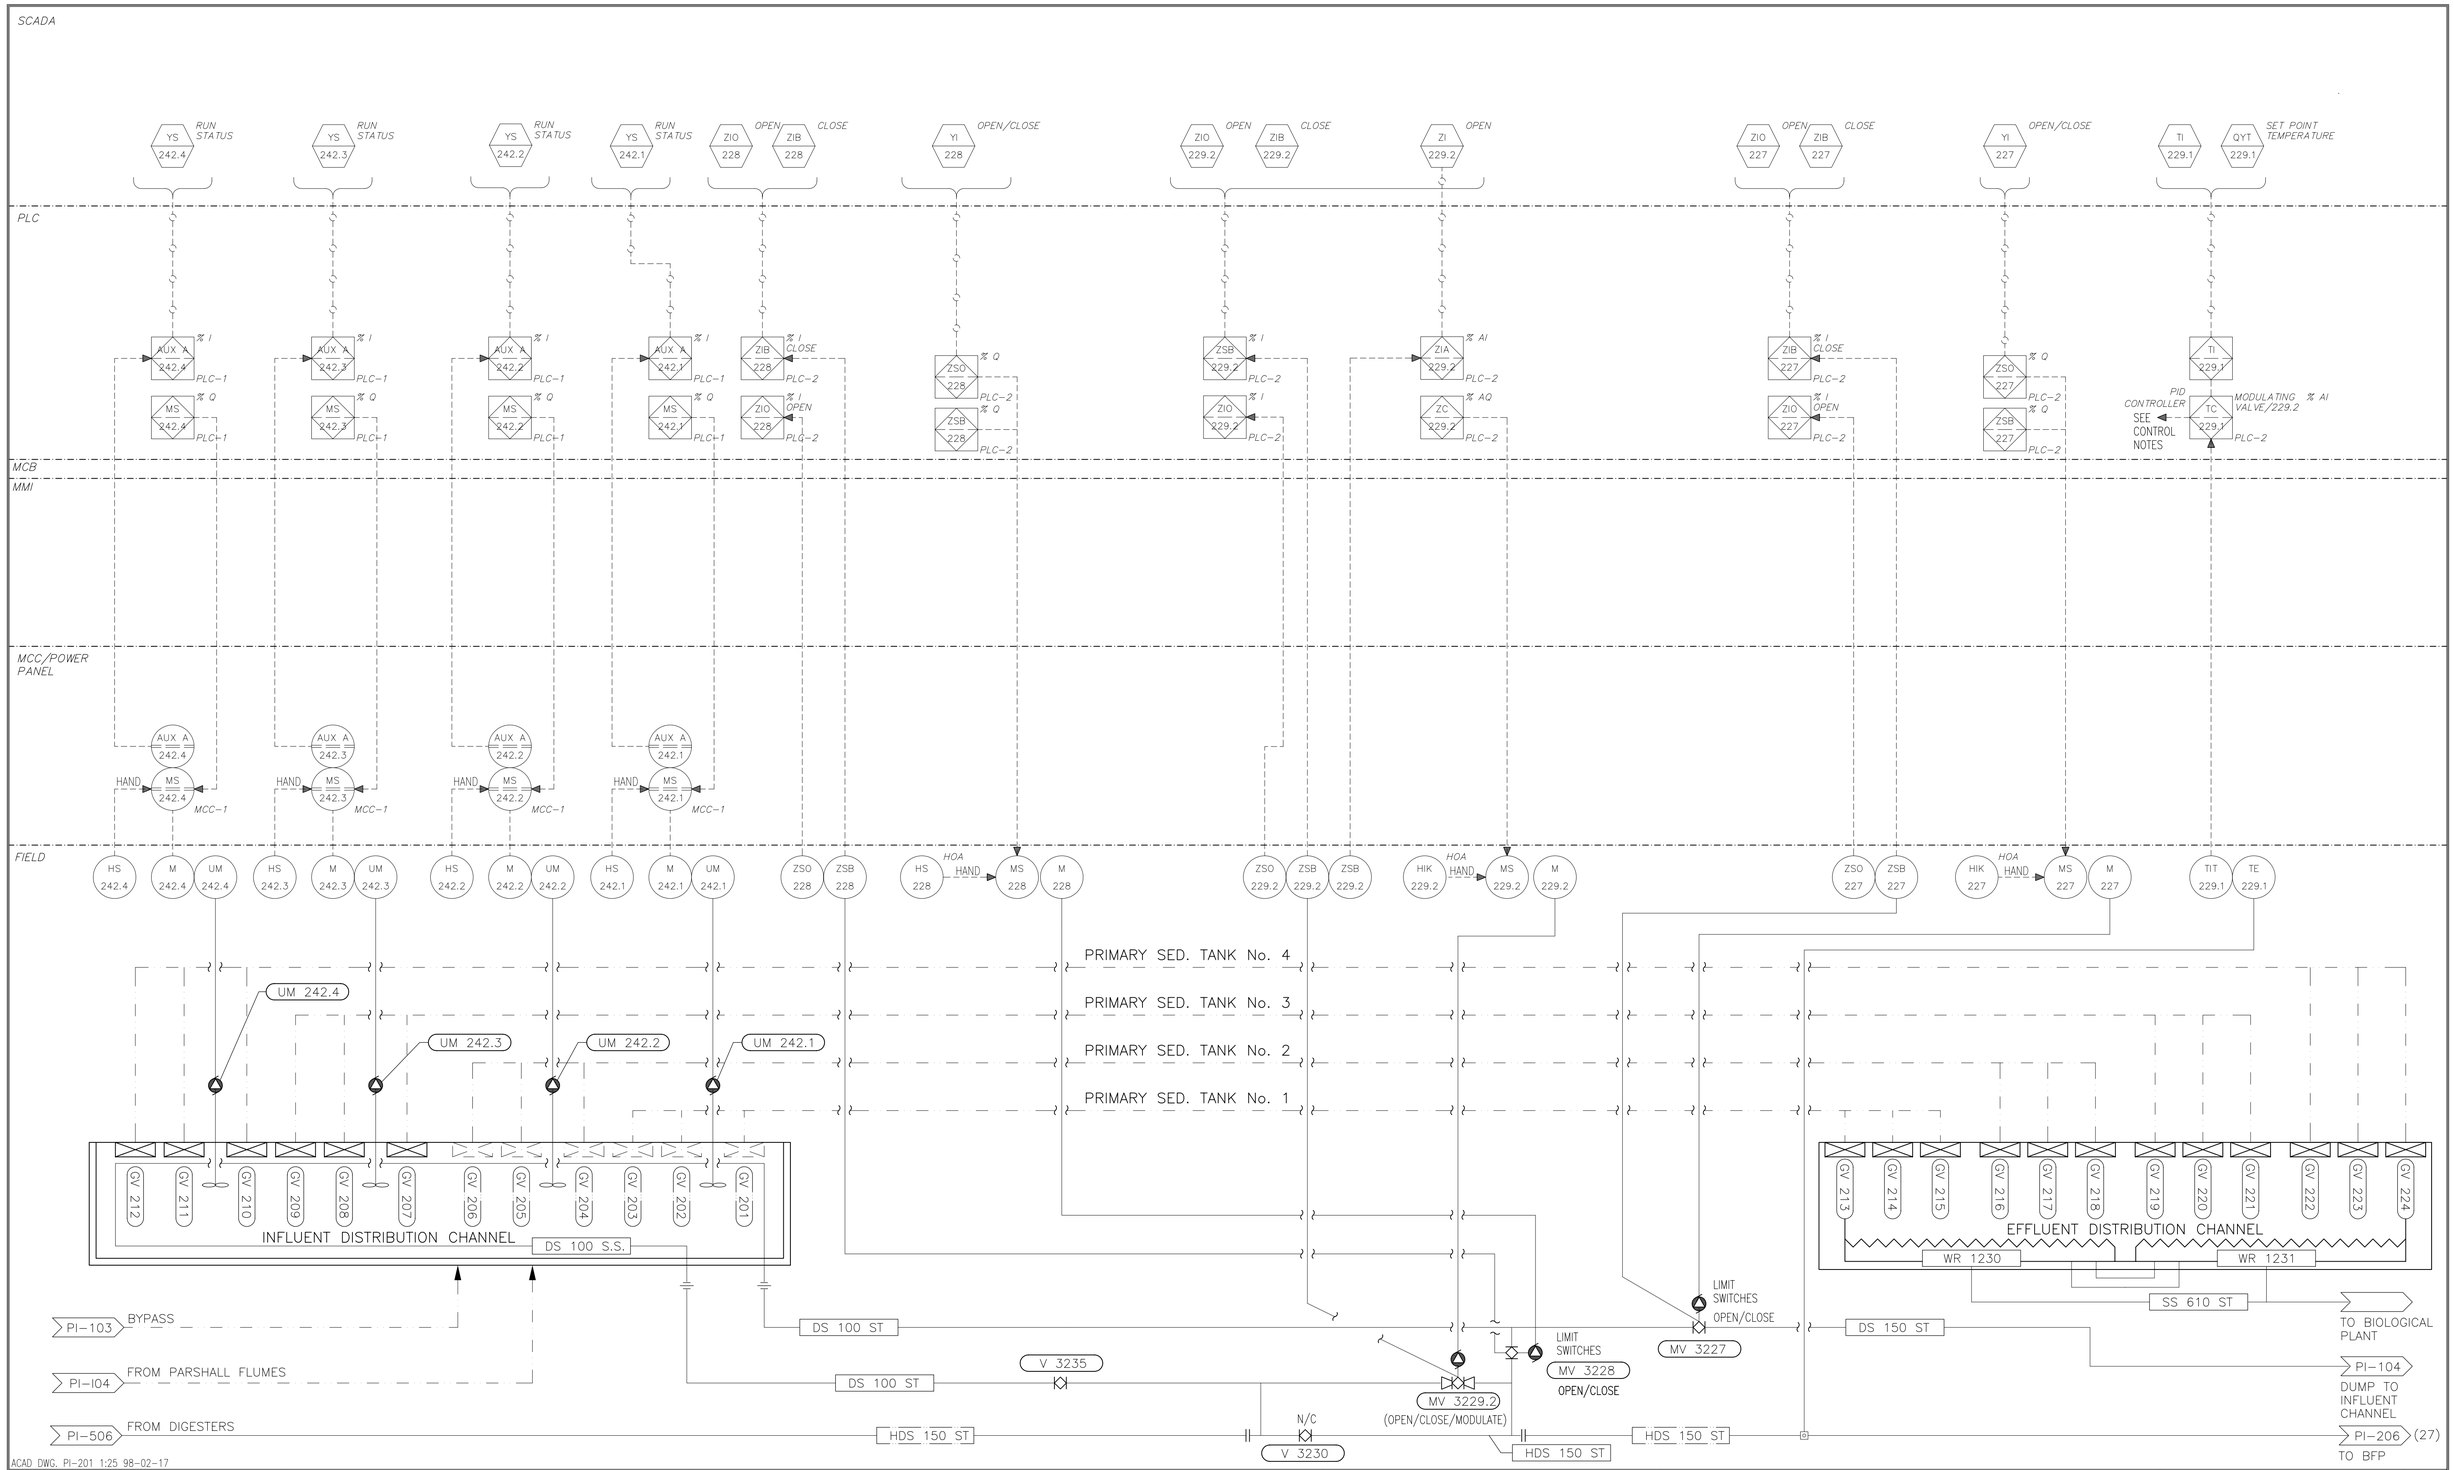

ACAD DWG. PI-201 1:25 98-02-17

REVISIONS	ISSUE	DATE	DRAWN	CHK'D	APP'D	DESCRIPTION	ISSUE	DATE	DRAWN	CHK'D	APP'D	DESCRIPTION
	B	APR/96	ES	HK	HK	ISSUED FOR CONSTRUCTION						
	C	FEB/98	GSAM	RW	RW	RECORD DRAWING						

AutoCAD DRAWING

DESIGNED HK
DRAWN G.SAM/ES
CHECKED

DAYTON & KNIGHT LTD.
Consulting Engineers

RESORT MUNICIPALITY OF WHISTLER
SEWAGE TREATMENT PLANT – STAGE III EXPANSION – CONTRACT 1
PRIMARY SEDIMENTATION INFLUENT – EFFLUENT CHANNELS
PROCESS AND INSTRUMENTATION DIAGRAM

SCALE: NTS
PI-201
DRAWING No. 179.11.1
SHEET 26 OF 249 ISSUE C