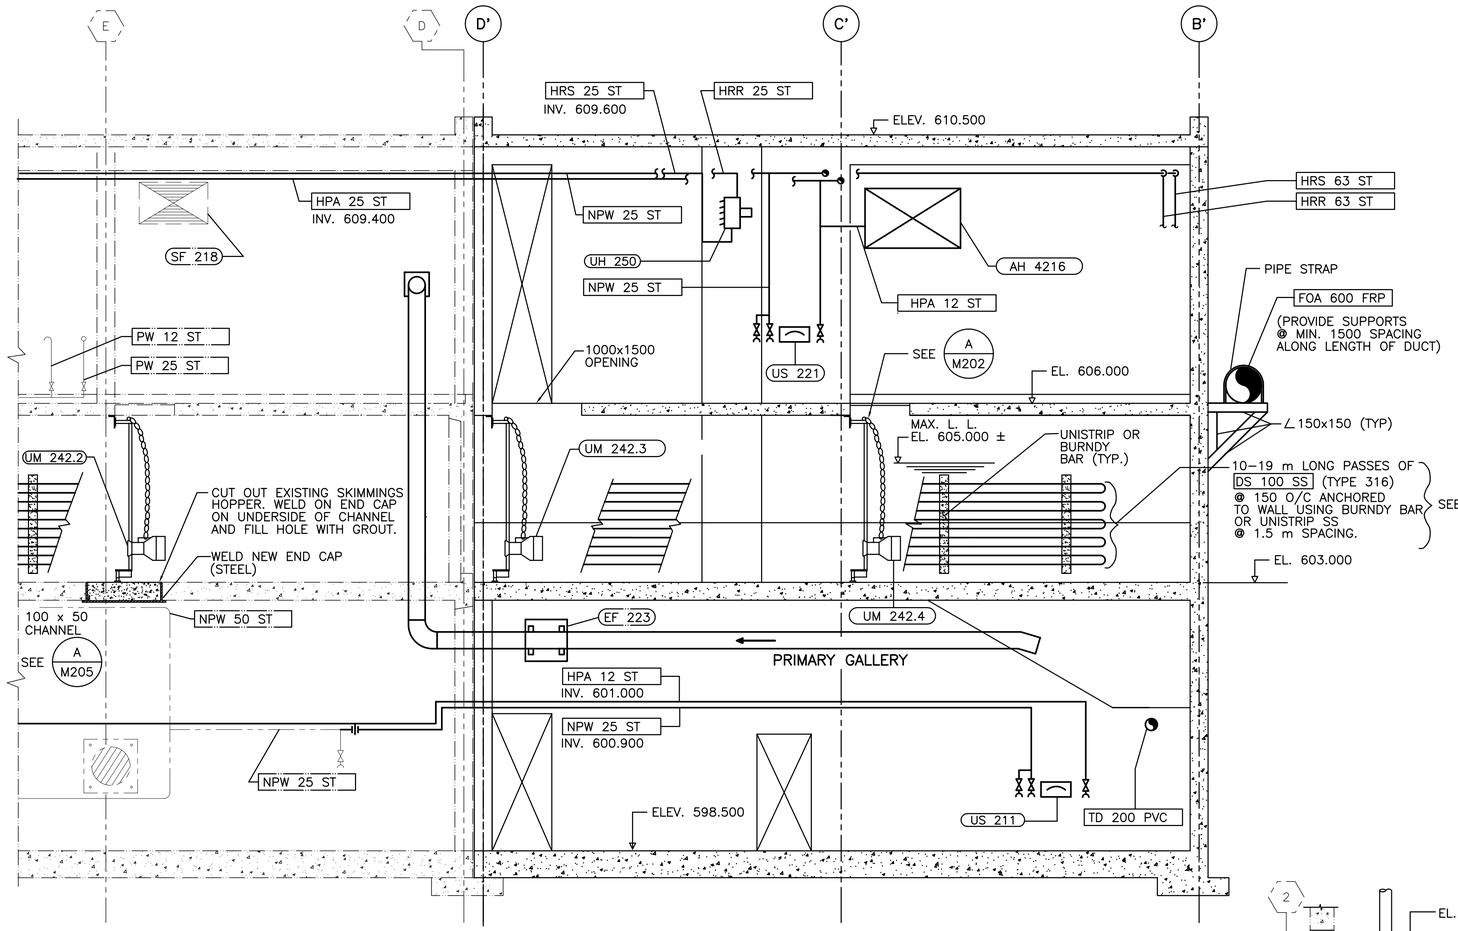

SECTION 3 / M202
1:50

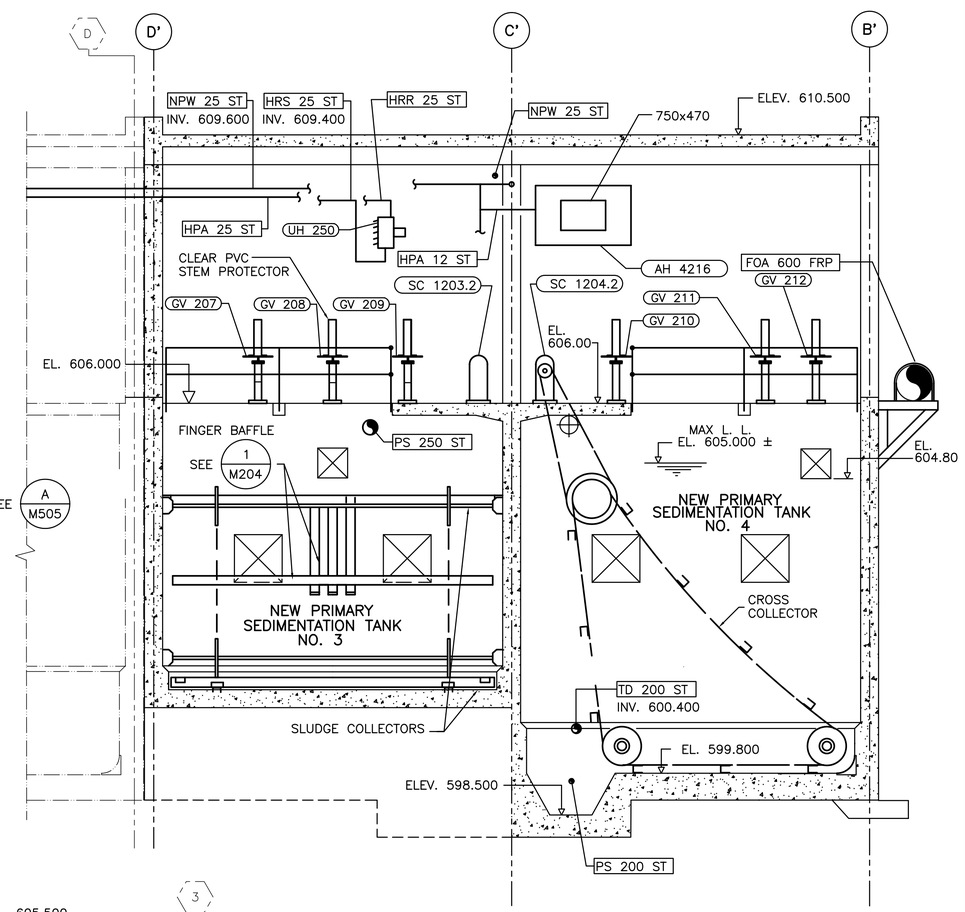

SECTION 4 / M202
1:50

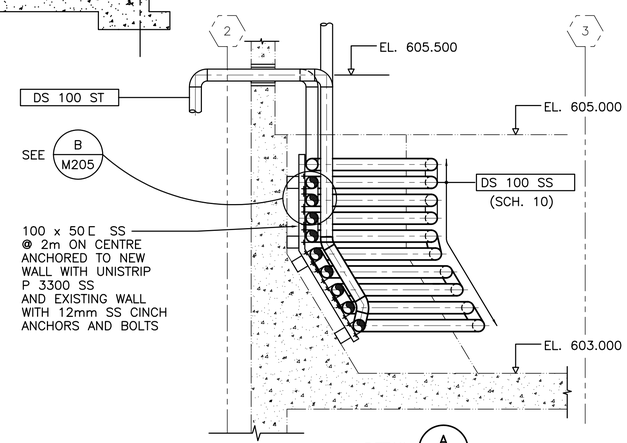

DETAIL A / M203
1:25

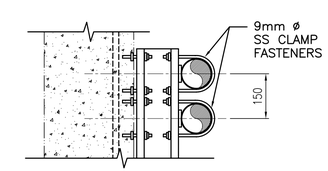

DETAIL B / M205
1:10

ACAD DWG. M205 1:50 98-02-18

AutoCAD DRAWING

REVISIONS

ISSUE	DATE	DRAWN	CHK'D	APP'D	DESCRIPTION	ISSUE	DATE	DRAWN	CHK'D	APP'D	DESCRIPTION
B	APR/96	LW	HK	HK	ISSUED FOR CONSTRUCTION						
C	FEB/98	JC			RECORD DRAWING						

DESIGNED H.P.W.
DRAWN WLP/DBC/ES
CHECKED HK

DAYTON & KNIGHT LTD.
Consulting Engineers

RESORT MUNICIPALITY OF WHISTLER
WASTEWATER TREATMENT PLANT–STAGE III EXPANSION–CONTRACT 1
PRIMARY SED. TANKS–SECTIONS

SCALE: 1:50
M205
DRAWING No. 179.11.1
SHEET 129 OF 249 ISSUE C