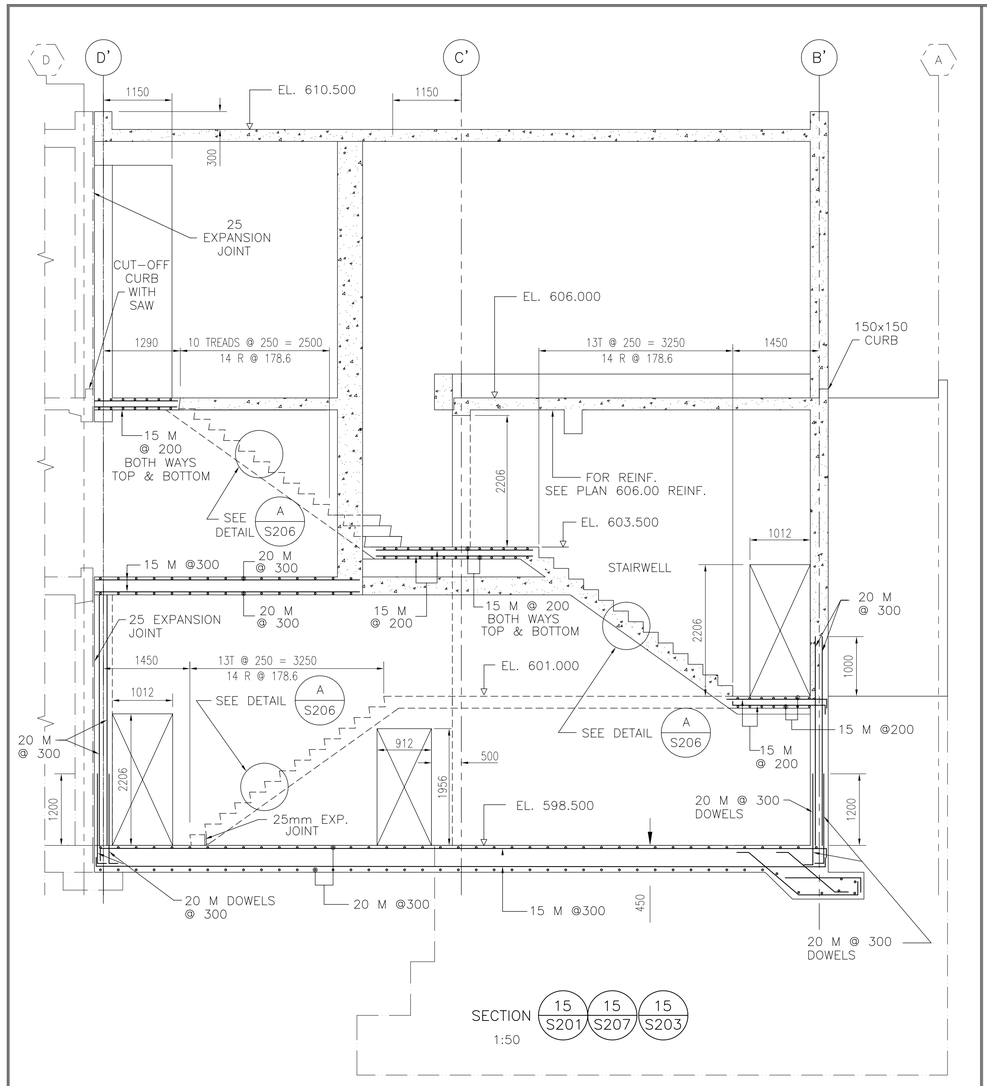

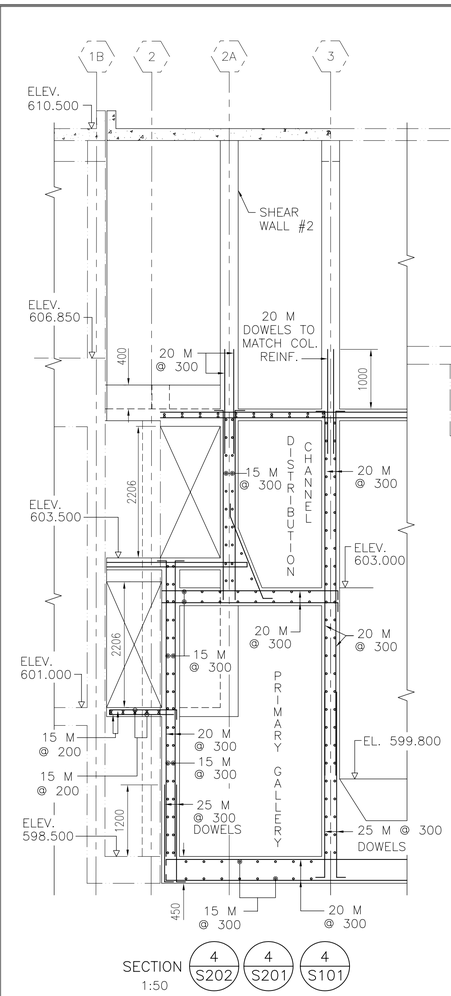

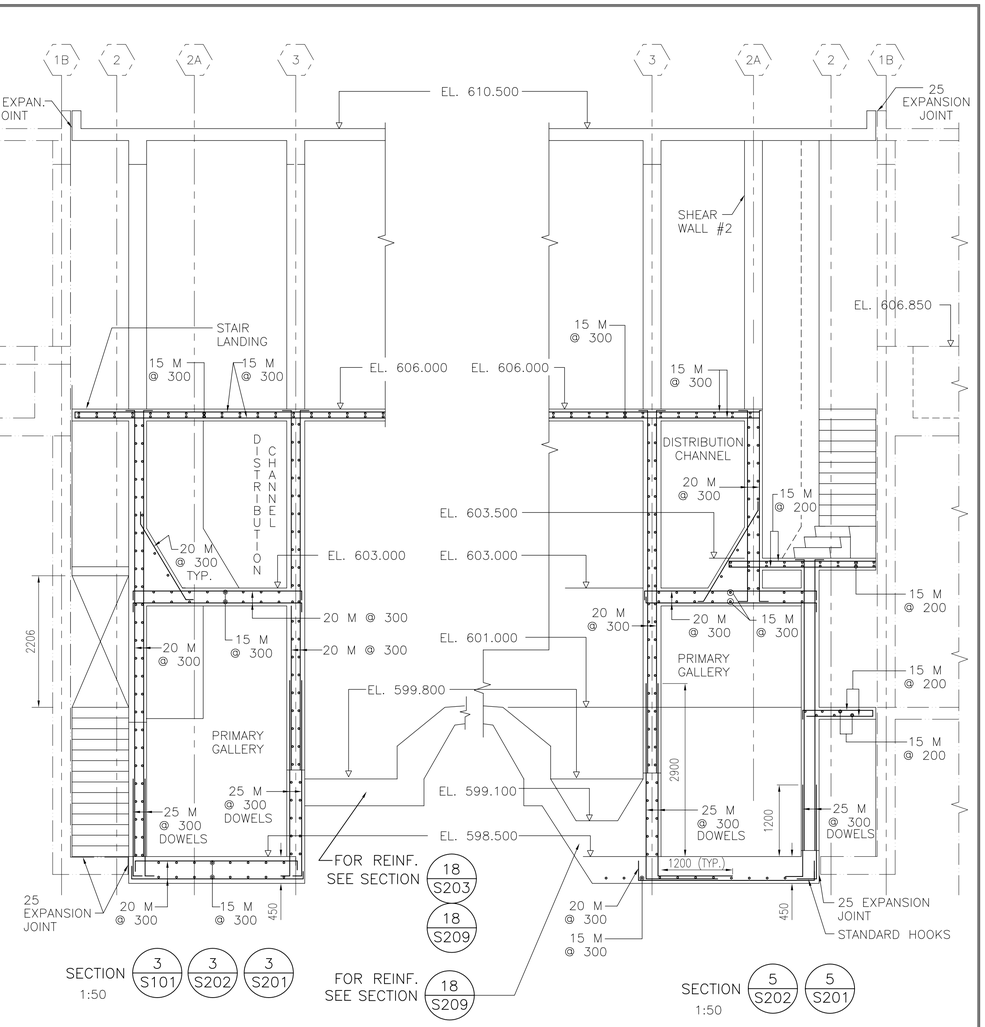

DETAIL B S206
1:25
TYPICAL FOOTING REINFORCEMENT
ALONG B', D' IS SIMILAR
BETWEEN 2 AND 12

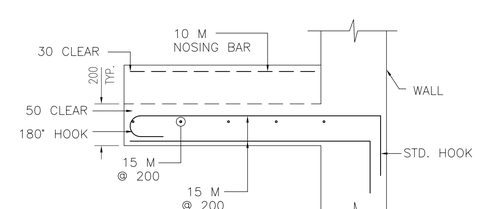

DETAIL A S206
TYP.
STAIR SECTION (TYP)

NOTE.

FOR WALL REINFORCEMENT ALL HORIZONTAL BARS 15 M @ 300 UNLESS OTHERWISE NOTED.

ACAD DWG.S206 1:50 98-02-23

AutoCAD DRAWING REVISIONS	ISSUE	DATE	DRAWN	CHK'D	APP'D	DESCRIPTION	ISSUE	DATE	DRAWN	CHK'D	APP'D	DESCRIPTION
	B	APR/96	DBC	S.O.	S.O.	ISSUED FOR CONSTRUCTION						
	C	JAN/98	JC			RECORD DRAWING						

DESIGNED R.W./S.O.
DRAWN W.L.P./KM
CHECKED H.K.

DAYTON & KNIGHT LTD.
Consulting Engineers

RESORT MUNICIPALITY OF WHISTLER
WASTEWATER TREATMENT PLANT–STAGE III EXPANSION–CONTRACT 1
PRIMARY SEDIMENTATION TANKS–REINFORCING

SCALE: 1:50 S206
DRAWING No. 179.11.1
SHEET 80 OF 249 ISSUE C