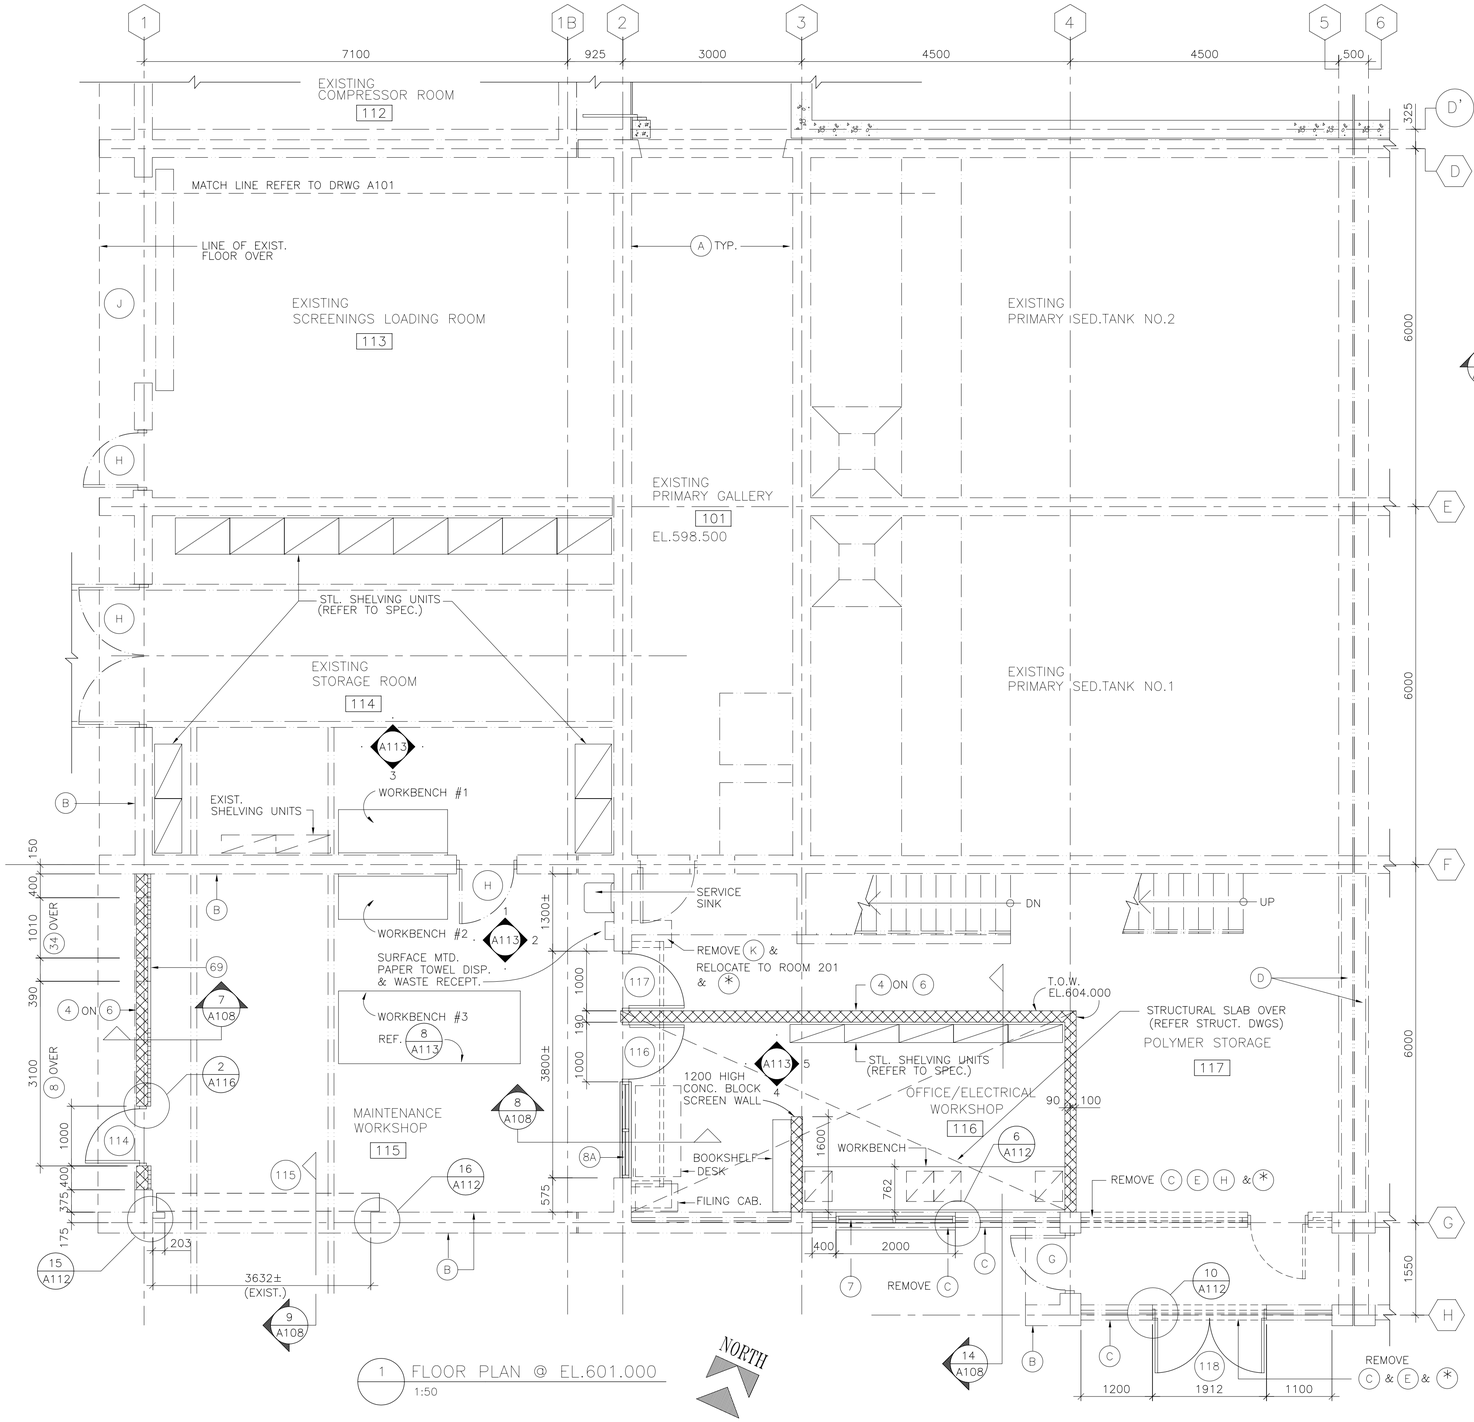

1 FLOOR PLAN @ EL.601.000
1:50

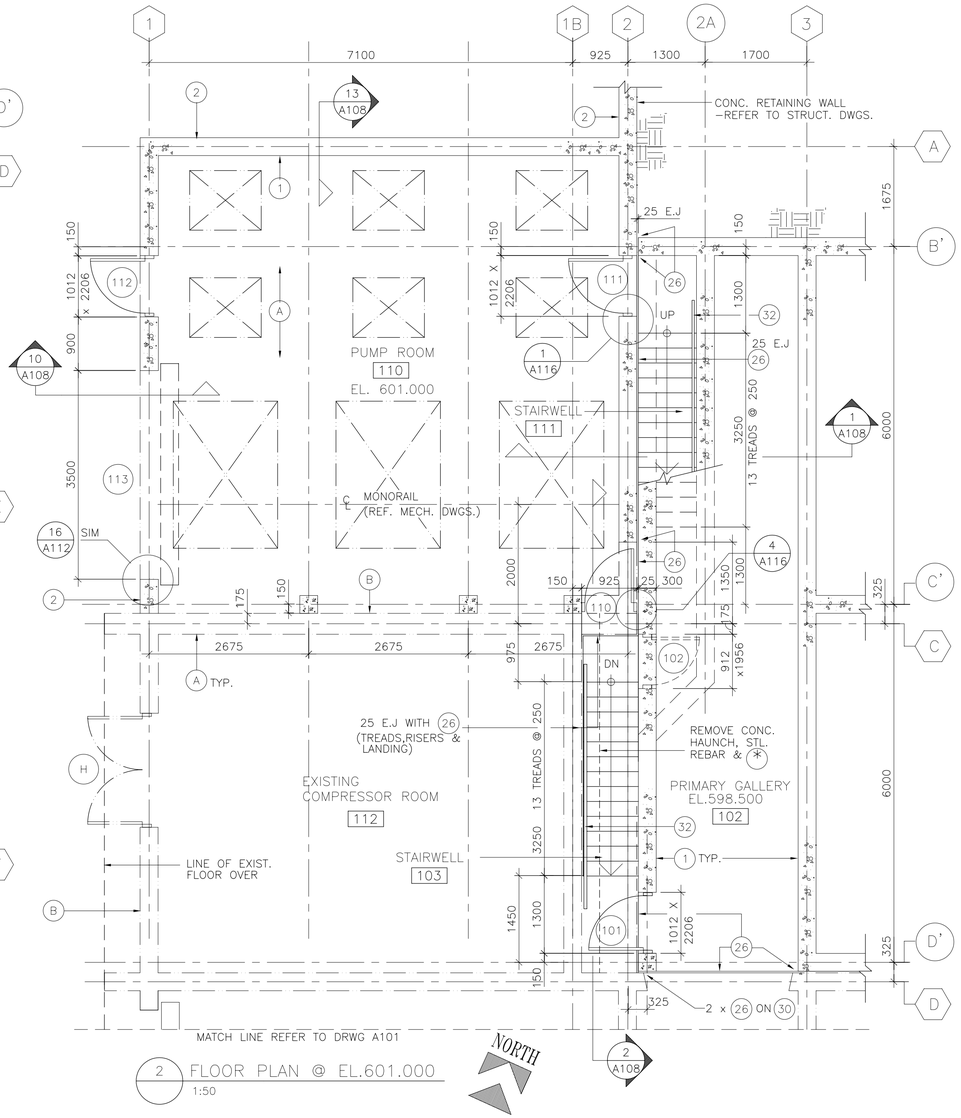

2 FLOOR PLAN @ EL.601.000
1:50

NOTE REFERENCES:

EXISTING CONSTRUCTION

- * MAKE GOOD ALL EXPOSED/DISTURBED SURFACES
- A CONCRETE
- B SANDBLASTED CONCRETE
- C 256mm INSULATED 90mm CONCRETE BLOCK CAVITY WALL
- D 190 CONCRETE BLOCK
- E 200H x 256W CONCRETE CURB
- G GLAZED METAL DOOR,FRAME & TRANSOM PANELS
- H METAL DOOR & FRAME
- J ROLL-UP DOOR
- K VERTICAL LIFT DOOR

NEW CONSTRUCTION

- 1 CONCRETE
- 2 SANDBLASTED CONCRETE
- 4 190mm CONC.BLOCK
- 6 200H x 190W CONC.CURB
- 7 25mm DOUBLE GLAZING IN ALUM. FRAMES
- 8 DOUBLE 6mm FLOAT GLASS IN 146 x 50mm STEEL FRAMES
- 8A SINGLE 6mm FLOAT GLASS IN 146 x 50mm STEEL FRAMES
- 26 CONTINUOUS SEALANT & BACK-UP ROD
- 30 2HR 100mm "FIRE BARRIER" FIRESTOPPING
- 32 GALV. STEEL HANDRAIL (REFER MECH. DWGS)
- 34 ALUM. WEATHER LOUVRE (W x H x D) (PAINT TO MATCH COLOUR OF ADJ. WALL FINISH)
- 69 13mm GYPSUM BOARD ON 'THERMAL-STUD' CHANNELS @ MAX. 610mm O.C. ON 50mm RIGID INSULATION ON CONCRETE OR 190mm CONC. BLOCK (FULL HT. TO U/S STRUCTURE)

TOBY RUSSELL BUCKWELL & partners architects
1650 ALBERNI STREET, VANCOUVER, B.C.
CANADA, V6G 1B1. TEL.: [604] 682-6881
FAX: [604] 682-3081

ACAD DWG. A101 1:50 96-04-24

AutoCAD DRAWING

REVISIONS

ISSUE	DATE	DRAWN	CHK'D	APP'D	DESCRIPTION	ISSUE	DATE	DRAWN	CHK'D	APP'D	DESCRIPTION
B	APR/96	E.S.	C.O.	C.O.	ISSUED FOR CONSTRUCTION						

DESIGNED D.K.M.
DRAWN B.D.C.
CHECKED C.O.

DAYTON & KNIGHT LTD.
Consulting Engineers

RESORT MUNICIPALITY OF WHISTLER
WASTEWATER TREATMENT PLANT–STAGE III EXPANSION – CONTRACT 1
HEADWORKS & PRIMARY SED TANKS
PLANS

SCALE: 1:50
A101/A201
DRAWING No. 179.11.1
SHEET 42 OF 249 ISSUE B