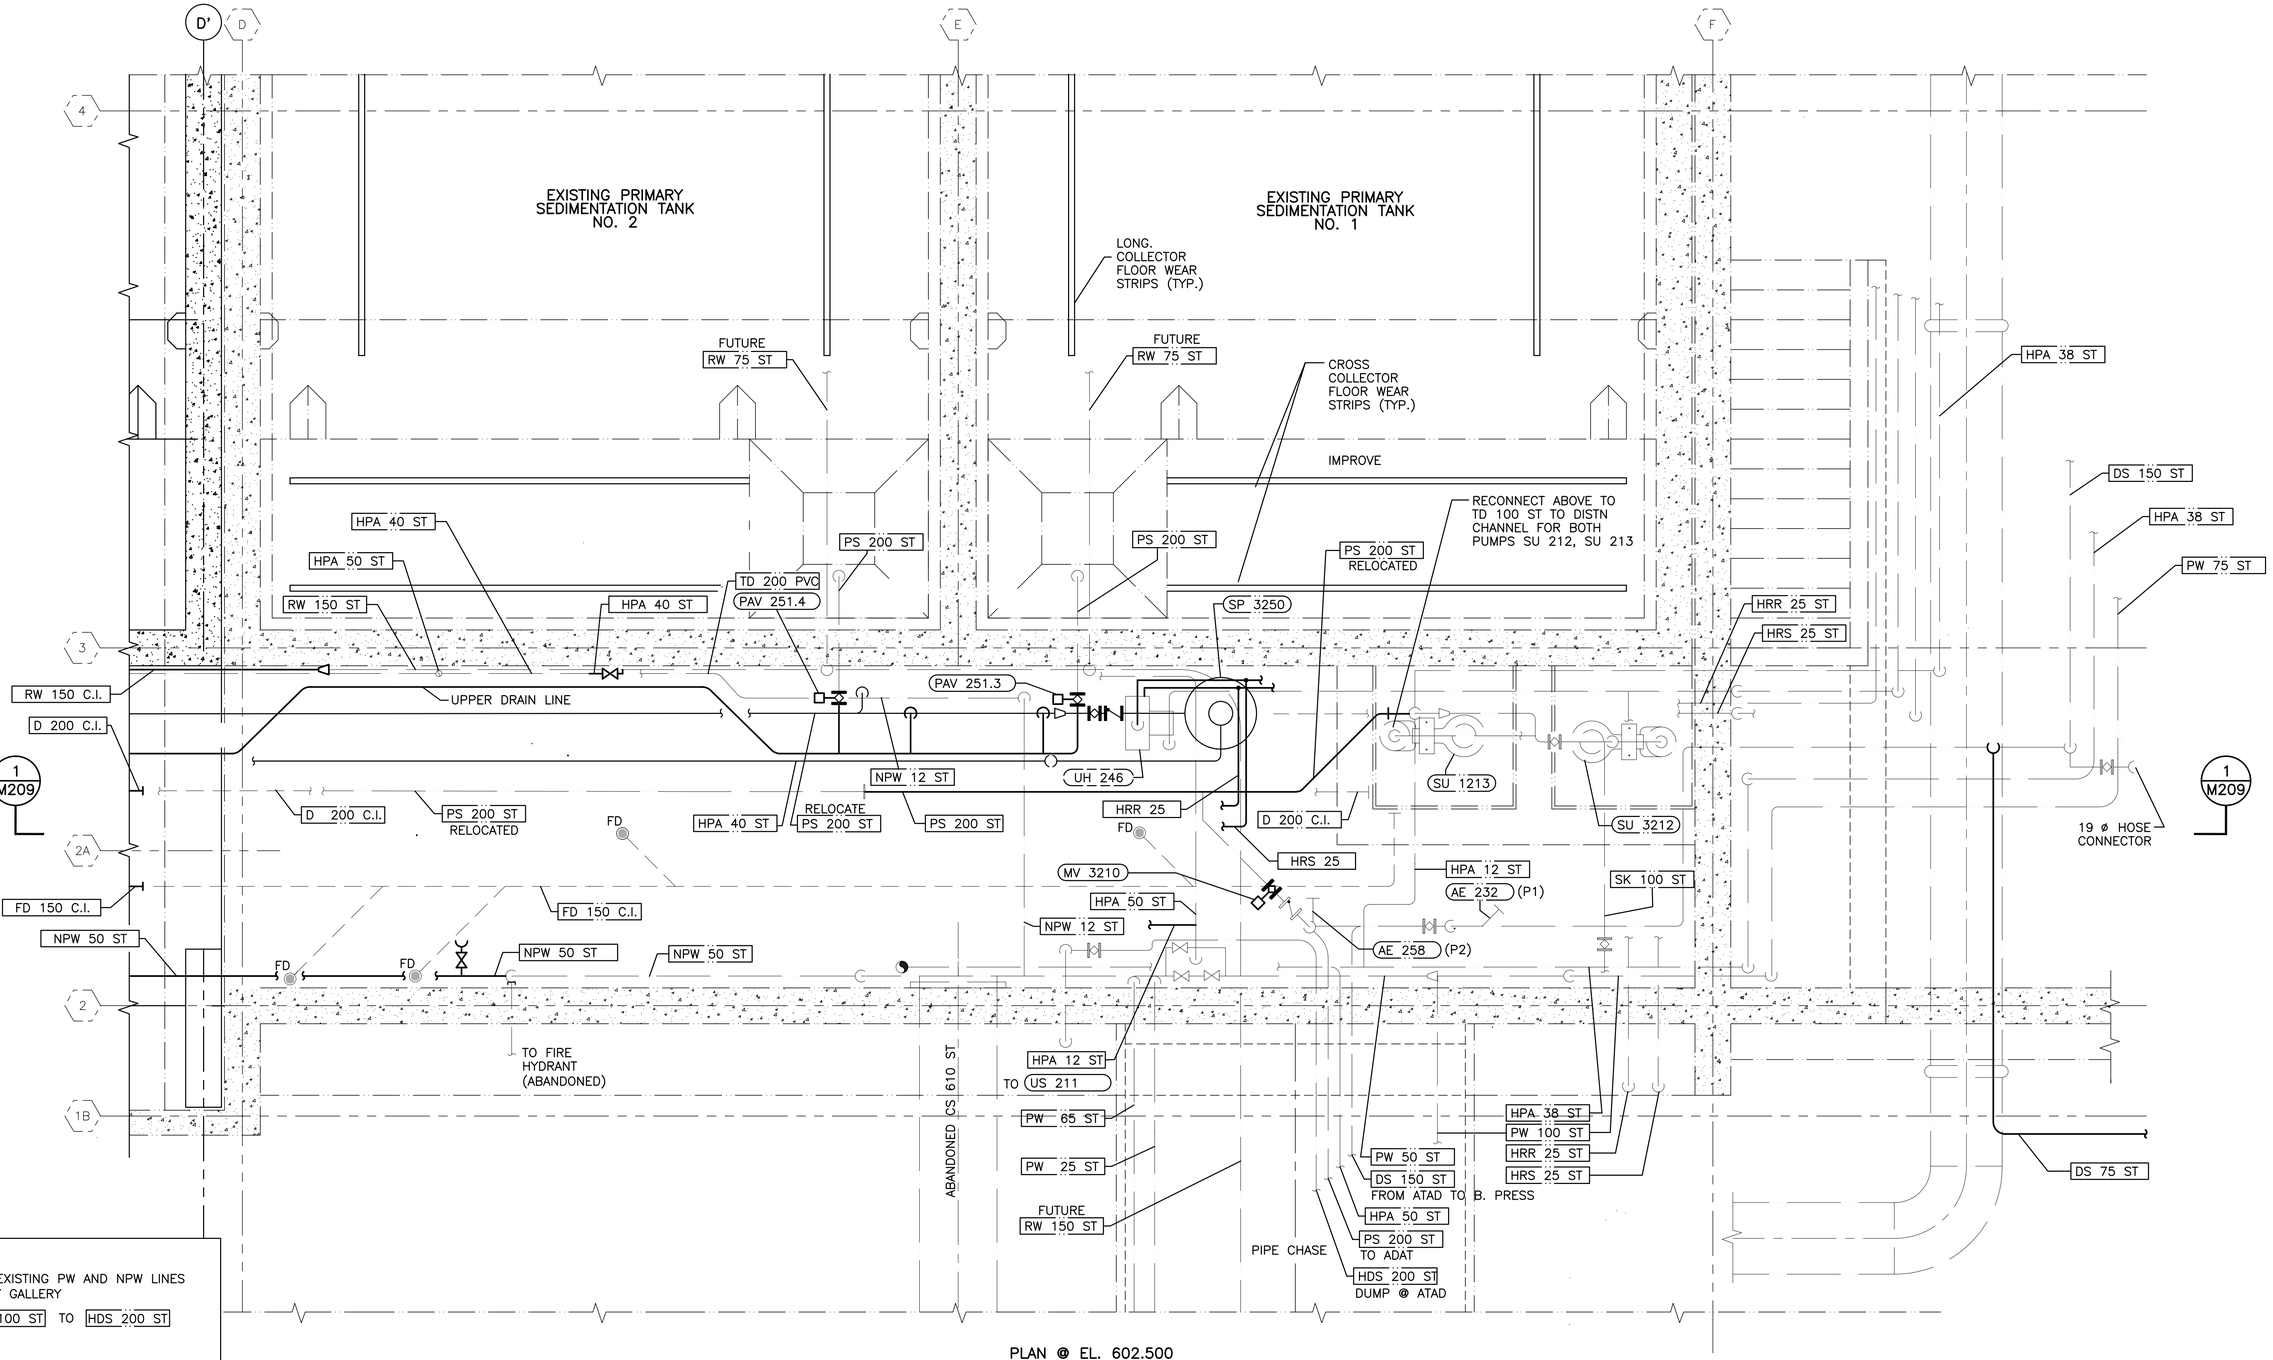

NOTES:

1. INSULATE ALL EXISTING PW AND NPW LINES INSIDE PRIMARY GALLERY
2. CONNECT SK 100 ST TO HDS 200 ST

PLAN @ EL. 602.500

1:25

ACAD DWG. M207 1:25 98-03-17

REVISIONS	ISSUE	DATE	DRAWN	CHK'D	APP'D	DESCRIPTION	ISSUE	DATE	DRAWN	CHK'D	APP'D	DESCRIPTION
	B	APR/96	LW	HK	HK	ISSUED FOR CONSTRUCTION						
	C	MAR/98	GSAM	R.W.	R.W.	RECORD DRAWING						

AutoCAD DRAWING

DESIGNED H.P.W.
DRAWN WSL/GS/ES
CHECKED H.K.

DAYTON & KNIGHT LTD.
Consulting Engineers

RESORT MUNICIPALITY OF WHISTLER
WASTEWATER TREATMENT PLANT–STAGE III EXPANSION–CONTRACT 1
EXISTING PRIMARY SED. TANKS–PARTIAL PLAN @ EL. 602.500

SCALE: 1:25
M207
DRAWING No. 179.11.1
SHEET 131 OF 249 ISSUE C